

CLAY  
F 2001  
6-66

MISSISSIPPI  
BOARD OF WATER COMMISSIONERS  
416 North State Street  
Jackson, Mississippi 39201

WATER WELL DRILLERS LOG

June 24, 1966 date well completed  
 Meridian-Human Well & Supply, Inc. firm  
 P.O. Box 42 firm location  
 CLAY county well located  
 MERIDIAN, MISSISSIPPI 39006

LANDOWNER:

L. D. Brewer  
 Rt 2 Pheba, Miss.  
 (mailing address)

description of formations encountered

description of formations encountered	from	to
surface sand & clay	0	40
blue clay	40	700
sand	700	820
bottom	820	

WELL LOCATION:


sec. 12 T. 20 N R. 5 E  
 2 miles N of Waddell  
 (distance) (direction) (nearest town)

WELL PURPOSE:

Home  
 (home, irrigation, municipal, industrial)

WELL COMPLETION DATA:

- diameter (inches) 5"
- total depth (feet) 820'
- static water level (feet) 60' below top of ground.
- casing steel, 43' (material) (depth)  
 (size) if telescope see back.
- screen NONE (length) (depth to top)  
 (size) (material)
- pump 1/2 (HP) 5 (yield gpm)  
 Electric (type power)
- electric log NO (yes or no)  
 (organization running log)
- how well bottom plugged OPEN

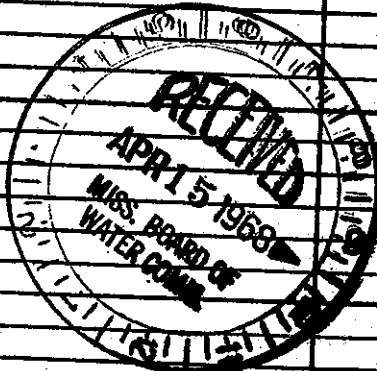

DRILLERS REMARKS: