

MISSISSIPPI
 BOARD OF WATER COMMISSIONERS
 416 North State Street
 Jackson, Mississippi 39201

WATER WELL DRILLERS LOG

CLAY
 F 2005
 4-67

4-11 1967 Herndon-Homan Well & Supply, Inc. *Clay*
 date well completed firm name Box 42 county well located
 SHANNON, MISSISSIPPI 39201


LANDOWNER:
 Leonard Christopher
 Pheba, Miss
 (mailing address)

description of formations encountered	from	to
surface sand & clay	0	40
blue clay	40	500
Special	500	940
Bottom	940	

WELL LOCATION: 20N
 sec. 8 T. 11 N. R. 13 E.
 2 miles N of Pheba
 (distance) (direction) (nearest town)

WELL PURPOSE: *None*
 (home, irrigation, municipal, industrial)

- WELL COMPLETION DATA:
- (1) diameter (inches) 5"
 - (2) total depth (feet) 940'
 - (3) static water level (feet) 100 below above top of ground.
 - (4) casing Steel 44' 7"
 (material) (depth)
5"
 (size) If telescope see back.
 - (5) screen None
 (length) (depth to top)
 (size) (material)
 - (6) pump 1/2 5
 (HP) (yield gpm)
Electric
 (type power)
 - (7) electric log no
 (yes or no)
 (organization running log)
 - (8) how well bottom plugged open

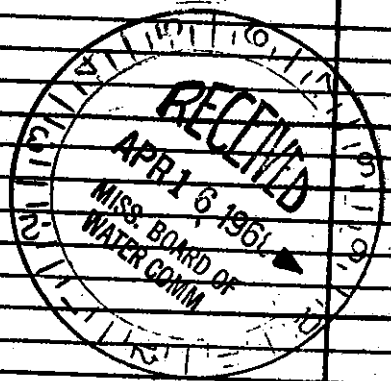

DRILLERS REMARKS: