

CLAY
F 2006
8-67

MISSISSIPPI BOARD OF WATER COMMISSIONERS

WATER WELL DRILLERS LOG

Date: 8-25, 1967, Driller: Harold-Norman Well & Sewer, Inc.
(When well drilled) (Name) P. O. Box 42 (Where well is located)
SEABRON, MISSISSIPPI 39282

(1) Owner of Land:	Description & Color of Materials Sand, Clay, Red Clay, Shell, etc.	Thick- ness Feet	Depth Feet
<u>Mrs. E. L. Dill</u> (Name)	<u>Surface sand & clay</u>	<u>0</u>	<u>30</u>
<u>Phoba Miss.</u> (Address)	<u>Blue clay</u>	<u>30</u>	<u>680</u>
(2) Location: <u>NE 1/4, SW 1/4, Sec. 23 T20N R4E</u>	<u>Sand</u>	<u>680</u>	<u>820</u>
<u>2 miles E</u> , of <u>Phoba</u> (distance) (direction) (Nearest Town)	<u>Bottom</u>	<u>820</u>	
(3) Topography: <u>Flat</u> (Hilly) (Flat) (Level)			
(4) Purpose of Well: <u>Home</u> (Domestic Irrigation Municipal, Industrial, Other)			

Information upon completion of well:

- (1) Diameter 5 inches.
- (2) Total Depth 820 feet.
- (3) Water Level 77 feet below top of ground.
- (4) Cased to 36', Size 5"
- (5) Screen: Size Bottom casing 1/2", Length 400'
- (6) Were any formations sealed against pollution?
 yes, no.

If YES depth of formation 30'


Why surface & sand

Drillers Remarks:

Yield in gpm: 5

Size pump: 1 1/2

Type power: electric

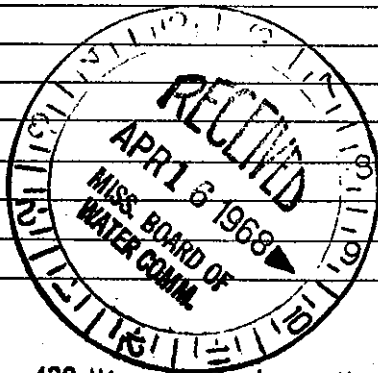

Mail this copy to Board of Water Commissioners 429 Miss. St. Jackson, Miss.