

CLAY
F 2007

8-67 MISSISSIPPI BOARD OF WATER COMMISSIONERS

WATER WELL DRILLERS LOG

Date: 8-21, 1967, Driller: Merndon-Homan Well & Supply, Inc.
(When well drilled) P. O. Box 42 County CLAY
SEANNOX, MISSISSIPPI 38868 (Name) (where well is located)

(1) Owner of Land:	Description & Color of Materials Sand, Clay, Red Clay, Shell, etc.	Thick- ness Feet	Depth Feet
<u>S. A. Ellis</u> (Name) <u>Phoba, Mississippi</u> (Address)	<u>surface sand & clay</u>	<u>0</u>	<u>37</u>
(2) Location: <u>NW 1/4, NW 1/4, Sec. 22 T. 20 N. R. 13 E.</u>	<u>Blue clay</u>	<u>37</u>	<u>780</u>
<u>1</u> miles <u>E</u> , of <u>Phoba</u> (distance) (direction) (Nearest Town)	<u>Gravel</u>	<u>780</u>	<u>900</u>
(3) Topography: <u>Flat</u> (Hilly) (Flat) (Level)	<u>Bottom</u>	<u>500</u>	
(4) Purpose of Well: <u>Home</u> (Domestic Irrigation Municipal, Industrial, Other)			

Information upon completion of well:

- (1) Diameter 5 inches.
- (2) Total Depth 900 feet.
- (3) Water Level 100 feet below top of ground.
- (4) Cased to 40' 9", Size 5"
- (5) Bottom casing 457', Screen Size 457', Length 2"
- (6) Were any formations sealed against pollution?
 yes, no.

If YES depth of formation 37'


Why surface & sand

Drillers Remarks:

Yield in gpm: 5

Size pump: 1/2 HP Sub.

Type power: Electric

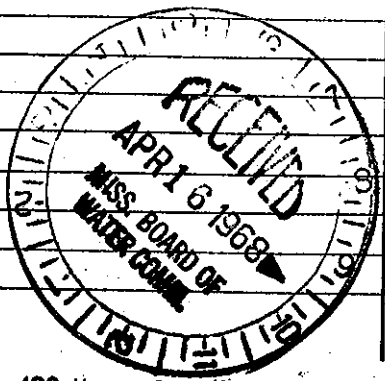

Mail this copy to Board of Water Commissioners 429 Miss. St. Jackson, Miss.