

CLAY
 G 59
 9-14-73

MISSISSIPPI
 BOARD OF WATER COMMISSIONERS
 416 North State Street
 Jackson, Mississippi 39201

CODED

WATER WELL DRILLERS LOG

9/14 1973 *Norman E. Ebbel* *Way*
 date well completed 1973 firm name county well located

LANDOWNER: *Leib Charles*
Highway # 50
West Point, Miss
 (mailing address)


description of formations encountered	from to	
	ft	ft
<i>Sandy clay</i>	0	12
<i>Chalk</i>	12	600
<i>Sand</i>	600	600

WELL LOCATION:
 sec 17 T 22 S R 14 E
 8 miles *West* of *West Point*
 (distance) (direction) (nearest town)

WELL PURPOSE: *Home*
 (home, irrigation, municipal, industrial)

- WELL COMPLETION DATA:
- (1) diameter (inches) 5"
 - (2) total depth (feet) 600
 - (3) static water level (feet) 80 below above top of ground.
 - (4) casing 2' 5" casing
 (material) (depth)
 (size) if telescope see back.
 - (5) screen 0
 (length) (depth to top)
 (size) (material)
 - (6) pump 1/2 7
 (HP) (yield gpm)
Electric
 (type power)
 - (7) electric log
 (yes or no)
 (organization running log)
 - (8) how well bottom plugged

CODED

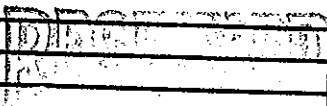

JAN 7 1974

DRILLERS REMARKS:

MISS. BD. OF WATER COMMISSIONERS