

CLAY MISSISSIPPI BOARD OF WATER COMMISSIONERS

G 2000
7-12-60

WATER WELL DRILLERS LOG
Herndon Well & Supply Co.
SHANNON, MISS.

6301

Date: July 12, 1960, Driller: _____ County Clay
(Name)

(1) Owner of Land:	Description & Color of Materials Sand, Clay, Red Clay, Shell, etc.	Thick- ness Feet	Depth Feet
<u>John Bryan</u> (Name) <u>West Point Contractor</u> (Address)	<u>Sand & Clay</u>		<u>21</u>
(2) Location: <u>1/4, 1/4, Sec. 8 T. 17 N. R. 11 E.</u> <u>17 MS SE</u> <u>2 miles East</u> , of <u>Cedar Bluff</u> (distance) (direction) (Nearest Town)	<u>Blue Bank</u> <u>Sand</u>		<u>21</u> <u>450</u>
(3) Topography: <u>Flat</u> (Hilly) (Flat) (Level)	<u>Bottom</u>		<u>575</u>
(4) Purpose of Well: <u>Home Use</u> (Domestic Irrigation Municipal, Industrial, Other)			


Information upon completion of well:

- (1) Diameter 4 inches.
- (2) Total Depth 575 feet.
- (3) Water Level 50 feet below top of ground.
- (4) Cased to 21 ft, Size 4"
- (5) Screen: Size _____, Length _____
- (6) Were any formations sealed against pollution?
 yes, _____ no.

If YES depth of formation 21 ft

Why Surface

Drillers Remarks: 90 ft deep pipe

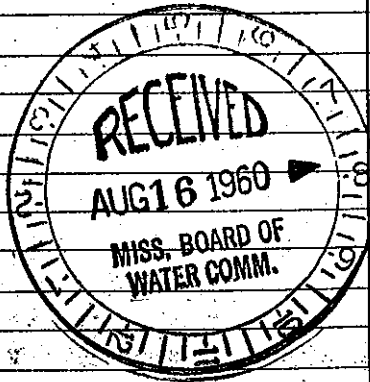

Well No. 6301

(Use Back Side)

Mail this copy to Board of Water Commissioners 429 Miss. St. Jackson, Miss