

CLAP MISSISSIPPI BOARD OF WATER COMMISSIONERS

G 2001

6300

7-13-60

WATER WELL DRILLERS LOG

Herndon Well & Supply Co.

Date: July 13, 1960, Driller: SHANNON, MISS. County CLAY

(Name)

(1) Owner of Land:	Description & Color of Materials Sand, Clay, Red Clay, Shell, etc.	Thick- ness Feet	Depth Feet
(Name) <u>Alvin Blake, Sr</u>			
(Address) <u>Cedar Bluff, Miss</u>	<u>SAND &amp; CLAY</u>		<u>21</u>
(2) Location: <u>517</u>	<u>Blue Rock</u>		<u>21</u>
1/4, 1/4, Sec <u>8</u>			
175 SE			
<u>2</u> miles <u>East</u> of <u>Cedar Bluff</u>	<u>SAND</u>	<u>460</u>	<u>460</u>
(distance) (direction) (Nearest Town)			
(3) Topography: <u>Flat</u>	<u>Bottom</u>		<u>580</u>
(Hilly) (Flat) (Level)			
(4) Purpose of Well: <u>Home Use</u>			
(Domestic Irrigation Municipal, Industrial, Other)			


Information upon completion of well:

- (1) Diameter 4 inches.
- (2) Total Depth 580 feet.
- (3) Water Level 30 feet below top of ground.
- (4) Cased to 21 ft, Size 4".
- (5) Screen: Size —, Length —.
- (6) Were any formations sealed against pollution?  
X yes, — no.

If YES depth of formation 21 ft

Why Surface

Drillers Remarks:

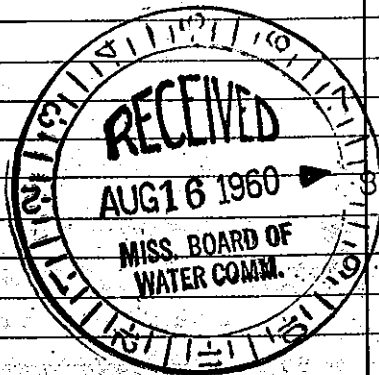

(Use Back Side)

Well No. 6300

Mail this copy to Board of Water Commissioners 429 Miss. St. Jackson, Miss.