

CLAY

G 2003

8-18-60

WATER WELL DRILLERS LOG

Herndon Well & Supply Co.

SHANNON, MISS.

6802

Date: Aug 18, 1960, Driller: _____ County CLAY

(Name)

(1) Owner of Land:	Description & Color of Materials Sand, Clay, Red Clay, Shell, etc.	Thick- ness Feet	Depth Feet
<u>Jehu Bryan, Jr.</u> (Name)	<u>Clay & Blue Rock</u>		<u>19</u>
<u>West Point, Miss. (Contractor)</u> (Address)	<u>SAND &</u>	<u>460</u>	
(2) Location: <u>1/4, 1/4, Sec. 8 20 17 17 5 SE</u> <u>2</u> miles <u>East</u> of <u>Cedar Bluff</u> (distance) (direction) (Nearest Town)	<u>Bottom</u>	<u>580</u>	
(3) Topography: <u>Flat</u> (Hilly) (Flat) (Level)			
(4) Purpose of Well: <u>Home Use</u> (Domestic Irrigation Municipal, Industrial, Other)			


Information upon completion of well:

- (1) Diameter 4 inches.
- (2) Total Depth 580 feet.
- (3) Water Level 50 feet below top of ground.
- (4) Cased to 21 ft Size 4"
- (5) Screen: Size _____, Length _____.
- (6) Were any formations sealed against pollution?
X yes, _____ no.

If YES depth of formation 19 ft

Why Surface

Drillers Remarks: _____

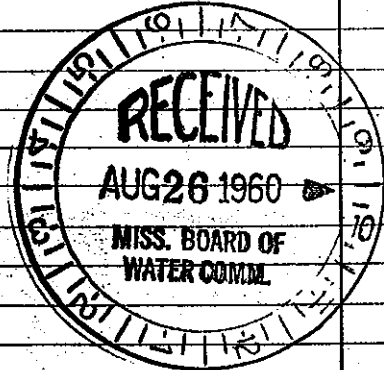

Well No. 6302

(Use Back Side)

Retain this copy for your office files.