

CLAY

MISSISSIPPI BOARD OF WATER COMMISSIONERS

G 2004
5-24-61

WATER WELL DRILLERS LOG
HERNDON WELL & SUPPLY CO.

C-306

Date: May 24, 1961, Driller: SHANNON, MISSISSIPPI County CLAY
P.O. BOX 42
(Name)

	Description & Color of Materials Sand, Clay, Red Clay, Shell, etc.	Thick- ness Feet	Depth Feet
(1) Owner of Land: <u>James Allen</u> (Name) <u>Color Bluff, Miss.</u> (Address)	<u>surface sand</u>		<u>0</u>
(2) Location: <u>1/4, 1/4, Sec 11, T 175 N, R 175 E</u> <u>6 miles East</u> of <u>Color Bluff</u> (distance) (direction) (Nearest Town)	<u>clay</u> <u>Blue water</u> <u>sand</u>		<u>17</u> <u>460</u>
(3) Topography: <u>Flat</u> (Hilly) (Flat) (Level)	<u>to</u>		
(4) Purpose of Well: <u>Domestic</u> (Domestic Irrigation Municipal, Industrial, Other)	<u>Bottom</u>		<u>580</u>


Information upon completion of well:

- (1) Diameter 4 inches.
- (2) Total Depth 580 feet.
- (3) Water Level 80 feet below top of ground.
- (4) Cased to 23'5", Size 4"
- (5) Screen: Size , Length .
- (6) Were any formations sealed against pollution?
 yes, no.

If YES depth of formation 20'

Why Surface & sand

Drillers Remarks:

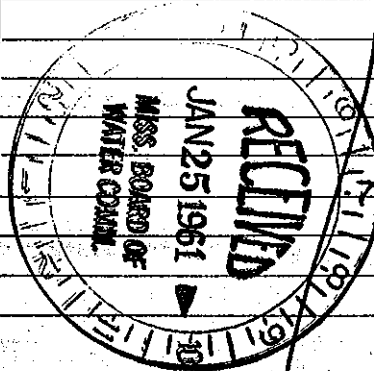

(Use Back Side)

Well No.

Mail this copy to Board of Water Commissioners 429 Miss. St. Jackson, Miss