

CLAY

G 2086


MISSISSIPPI BOARD OF WATER COMMISSIONERS

9-15-62

WATER WELL DRILLERS LOG

Date Sept 15, 1962, Driller: HERNDON WELL & SUPPLY CO.  
P. O. BOX 42 County Clay  
SIANNON, MISSISSIPPI

(1) Owner of Land:	Description & Color of Materials Sand, Clay, Red Clay, Shell, etc.	Thick- ness Feet	Depth Feet
<u>Bob Marshall</u> (Name) <u>Cedar Bluff, Miss.</u> (Address)	<u>gypsum sand clay</u>	0	0
(2) Location: <u>1/4</u> , <u>1/4</u> , Sec. <u>21</u> T <u>20</u> R <u>14E</u>	<u>lime rock</u>	5	11
<u>1</u> miles <u>W</u> , of <u>Cedar Bluff</u> (distance) (direction) (Nearest Town)	<u>Blue rock</u>	8	17
(3) Topography: <u>Flat</u> (Hilly) (Flat) (Level)	<u>Rock</u>	5	330
(4) Purpose of Well: <u>Domestic</u> (Domestic Irrigation Municipal, Industrial, Other)	<u>Gumbo</u>	5	335
Information upon completion of well:	<u>Sand</u>	5	575
(1) Diameter <u>4</u> inches.	<u>Rock</u>	5	660
(2) Total Depth <u>720</u> feet.	<u>Sand</u>	5	664
(3) Water Level <u>60</u> feet below top of ground.	<u>Bottom</u>	5	664
(4) Cased to <u>22'5"</u> , Size <u>4"</u>			720
(5) Screen: Size <u>    </u> , Length <u>    </u>			
(6) Were any formations sealed against pollution? <u>  </u> yes, <u>    </u> no.			
If YES depth of formation <u>17 ft</u>			
Why <u>Gypsum &amp; sand</u>			
Drillers Remarks:			

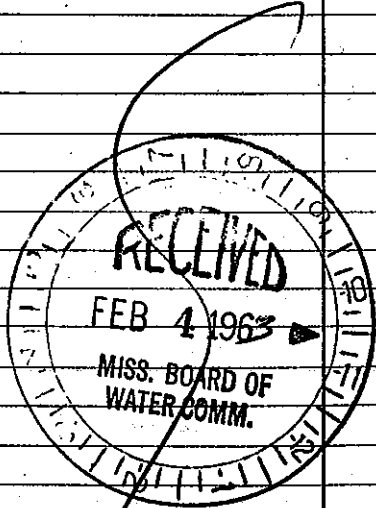

Well No.

(Use Back Side)

Mail this copy to Board of Water Commissioners, 429 Miss. St. Jackson, Miss.