

CLAY MISSISSIPPI BOARD OF WATER COMMISSIONERS

G 2007
12-18-63

WATER WELL DRILLERS LOG
HERNDON WELL & SUPPLY CO.

Date: Dec 12, 1963, Driller: SPANNON, MISSISSIPPI P.O. BOX 42 County Clay
(Name)

	Description & Color of Materials Sand, Clay, Red Clay, Shell, etc.	Thick- ness Feet	Depth Feet
(1) Owner of Land: <u>J. N. Bryan, Inc.</u> (Name)	<u>Sandy clay</u>		<u>0</u>
Address: <u>Arvey Sub, West Point, Miss</u> <u>Cedar Bluff</u>	<u>Blue sand</u>	<u>0</u>	<u>18</u>
(2) Location: <u>1/4, 1/4, Sec 17, T. 17 S, R. 5 E</u> <u>2 miles NE of Cedar Bluff</u> (distance) (direction) (Nearest Town)	<u>gravel</u>	<u>0</u>	<u>440</u>
(3) Topography: <u>Flat</u> (Hilly) (Flat) (Level)	<u>Bottom</u>		<u>580</u>
(4) Purpose of Well: <u>Domestic</u> (Domestic Irrigation Municipal, Industrial, Other)			


Information upon completion of well:

- (1) Diameter 4 inches.
- (2) Total Depth 580 feet.
- (3) Water Level 70 feet below top of ground.
- (4) Cased to 21' 4", Size 4".
- (5) Screen: Size —, Length —.
- (6) Were any formations sealed against pollution?
— yes, — no.

If YES depth of formation 18'

Why surface to sand

Drillers Remarks:

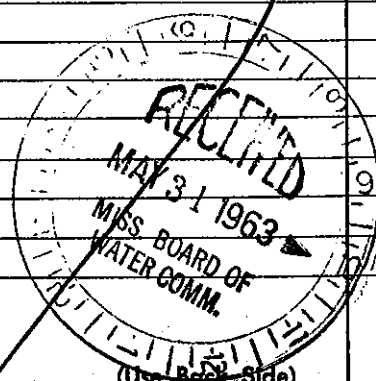

Well No.

Mail this copy to Board of Water Commissioners 429 Miss. St. Jackson, Miss.