

CLAY
 B2009
 7-66

MISSISSIPPI BOARD OF WATER COMMISSIONERS

WATER WELL DRILLERS LOG

Date: July 9, 1966, Driller: Marndon-Homan Well & Supply, Inc. County: CLAY
(When well drilled) (Name) P. O. Box 42 (Where well is located)
SHAWNO, MISSISSIPPI 39088

(1) Owner of Land: <u>Tenny Woods</u> <small>(Name)</small>	Description & Color of Materials Sand, Clay, Red Clay, Shell, etc.	Thick- ness Feet	Depth Feet
<u>West Point, Miss.</u> <small>(Address)</small>	<u>surface sand & clay</u>	<u>0-16</u>	
(2) Location: <u>NE 1/4 SW 1/4, Sec. 10 T17S R5E</u> <u>1 1/2 miles SW</u> , of <u>Silgram</u> <small>(distance)</small> <small>(direction)</small> <small>(Nearest Town)</small>	<u>Blue clay sand Bottom</u>	<u>16-420 420-540 540</u>	
(3) Topography: <u>Flat</u> <small>(Hilly) (Flat) (Level)</small>			
(4) Purpose of Well: <u>Domestic</u> <small>(Domestic Irrigation Municipal, Industrial, Other)</small>			

Information upon completion of well:

(1) Diameter 4 inches.

(2) Total Depth 540 feet.

(3) Water Level 60 feet below top of ground.

(4) Cased to 20' 9", Size 4"

(5) Screen: Size —, Length —

(6) Were any formations sealed against pollution?
 yes, no.

If YES depth of formation 16'


Why surface sand

Drillers Remarks:

Yield in gpm: 5 gpm

Size pump: 3/4 HP Jet

Type power: Electric

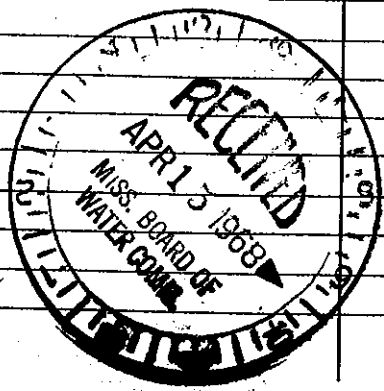

Mail this copy to Board of Water Commissioners 429 Miss. St. Jackson, Miss.