

Clay  
G 7017  
6-68

MISSISSIPPI  
BOARD OF WATER COMMISSIONERS  
416 North State Street  
Jackson, Mississippi 39201

WATER WELL DRILLERS LOG

Wernholm-Homan Well & Supply, Inc. *Clay*

P. O. Box 42

date well completed 6-5 1968 SHANNON, MISSISSIPPI county well located


LANDOWNER:  
Levil Charles  
Box 1 Cedar Bluff Miss  
(mailing address)

description of formations encountered	from	to
<u>Yellow Sand &amp; clay</u>	<u>0</u>	<u>35</u>
<u>Clay</u>	<u>35</u>	<u>46</u>
<u>Sand</u>	<u>46</u>	<u>580</u>
<u>Gravel</u>	<u>580</u>	

WELL LOCATION:  
sec. 17 17S R. 5E  
2 miles NE of Cedar Bluff  
(distance) (direction) (nearest town)

WELL PURPOSE:  
Home  
(home, irrigation, municipal, industrial)

- WELL COMPLETION DATA:
- (1) diameter (inches) 5"
  - (2) total depth (feet) 580'
  - (3) static water level (feet) 58' below top of ground.
  - (4) casing Steel 40'  
(material) (depth)  
5" If telescope see back.  
(size)
  - (5) screen ND  
(length) (depth to top)  
(size) (material)
  - (6) pump 3/4 5  
(HP) (yield gpm)  
electric  
(type power)
  - (7) electric log ND  
(yes or no)  
(organization running log)
  - (8) how well bottom plugged open

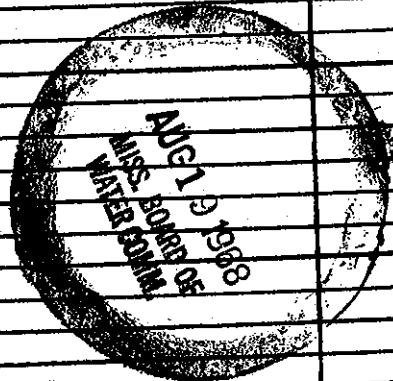

DRILLERS REMARKS: