

CLAY  
H45

MISSISSIPPI BOARD OF WATER COMMISSIONERS

QW 1326

12-5-61

WATER WELL DRILLERS LOG


**CODED**

Date: 12-5-1961, Driller: Layne-Central Co. County: Clay

(Name)

(1) Owner of Land: <u>City of West Point</u> (Name)	Description & Color of Materials Sand, Clay, Red Clay, Shell, etc.	Thick- ness Feet	Depth Feet
<u>West Point, Mississippi</u> (Address)	Top soil	2	2
(2) Location: <u>1/4</u> , <u>1/4</u> , Sec. <u>15</u> T. <u>15</u> R. <u>6E</u>	white clay	6	8
_____ miles _____ of _____ (distance) (direction) (Nearest Town)	red clay	6	14
(3) Topography: _____ (Hilly) (Flat) (Level)	hard brittle clay	2	16
(4) Purpose of Well: <u>Municipal</u> (Domestic Irrigation Municipal, Industrial, Other)	hard blue soapstone	125	141
Information upon completion of well:	lime rock & shells	4	145
(1) Diameter <u>16"</u> inches.	sandy clay	47	192
(2) Total Depth <u>382'</u> feet.	sandy shale	37	229
(3) Water Level <u>82'</u> feet below top of ground.	rock	1	230
(4) Cased to <u>299'</u> , Size <u>16"</u>	sandy clay & shells	7	237
(5) Screen: Size <u>8"</u> , Length <u>70'</u>	rock	1	238
(6) Were any formations sealed against pollution? <u>X</u> yes, _____ no.	hard fine sand & clay stks	10	248
If YES depth of formation <u>299'</u>	rock	3	251
Why <u>Required</u>	hard fine sand	24	275
Drillers Remarks:	brittle clay	5	280
	blue clay	9	289
	hard fine sand-clay stks	93	382
	clay	2	384

**CODED**

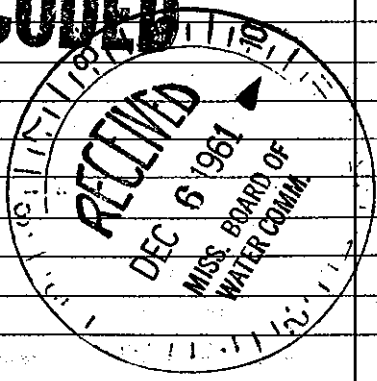

(Use Back Side)

Mail this copy to Board of Water Commissioners 429 Miss. St. Jackson