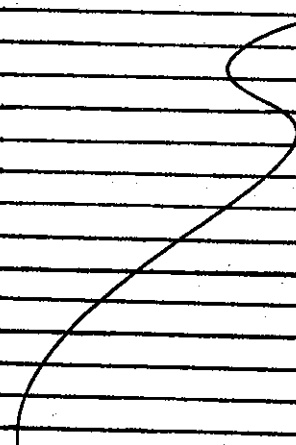


Clay  
H 55  
12-2-68

MISSISSIPPI  
BOARD OF WATER COMMISSIONERS CODED  
416 North State Street  
Jackson, Mississippi 39201

WATER WELL DRILLERS LOG

12-2-19 Herndon-Homan Well & Supply, Inc. CLAS  
date well completed  
firm name Box 42  
BEAUNTON, MISSISSIPPI 38809 county well located

<p>LANDOWNER: 4946932 Emergine Harrison 22 West Point, Miss. (mailing address)</p>	<p>description of formations encountered super clay Btu sand Btu</p>	<p>from 0 16 16 280 400</p>	<p>to 16 280 400</p>
<p>WELL LOCATION: sec. 24 T. 16 N. R. 6 E S W 4 miles NE of West Point (distance) (direction) (nearest town)</p>			
<p>WELL PURPOSE: Home (home, irrigation, municipal, industrial)</p>			
<p>WELL COMPLETION DATA:</p> <p>(1) diameter (inches) 5"</p> <p>(2) total depth (feet) 400</p> <p>(3) static water level (feet) 96' below top of ground.</p> <p>(4) casing Steel 21' 4" (material) (depth)</p> <p>(size) If telescope see back.</p> <p>(5) screen NO (length) (depth to top)</p> <p>(size) (material)</p> <p>(6) pump 1/3 (HP) 5 (yield gpm) electric (type power)</p> <p>(7) electric log NO (yes or no)</p> <p>(organization running log)</p> <p>(8) how well bottom plugged open</p>	<p>CODED</p>		
<p>DRILLERS REMARKS:</p>			