

CLAY MISSISSIPPI BOARD OF WATER COMMISSIONERS

H103
7-5-65

WATER WELL DRILLERS LOG

CODED

Date: July 5, 1965, Driller: Herndon-Homan Well & Supply, Inc.
P. O. Box 42 County Clay
SHANNON, MISSISSIPPI 38868

(1) Owner of Land: <u>DORA HALL</u> <small>(Name)</small>	Description & Color of Materials Sand, Clay, Red Clay, Shell, etc.	Thick- ness Feet	Depth Feet
<u>At 2 West Point, Miss.</u> <small>(Address)</small>	<u>surface sand & clay</u>		<u>0-22</u>
(2) Location: <u>SW 1/4, NE 1/4, Sec 25, T. 16 S., R. 6 E.</u>	<u>Blue clay</u>		<u>22-280</u>
<u>5</u> miles <u>NE</u> , of <u>West Point</u> <small>(distance) (direction) (Nearest Town)</small>	<u>Sand</u>		<u>280-400</u>
(3) Topography: <u>Flat</u> <small>(Hilly) (Flat) (Level)</small>	<u>Bottom</u>		<u>400</u>
(4) Purpose of Well: <u>Domestic</u> <small>(Domestic Irrigation Municipal, Industrial, Other)</small>			

Information upon completion of well:

CODED

(1) Diameter 4 inches.

(2) Total Depth 400 feet.

(3) Water Level 90' feet below top of ground.

(4) Cased to 24', Size 4"


(5) Screen: Size _____, Length _____

(6) Were any formations sealed against pollution?
 yes, _____ no.

If YES depth of formation 22'

Why surface & sand

Drillers Remarks: Elev. = ± 252 at top 20'
90
162

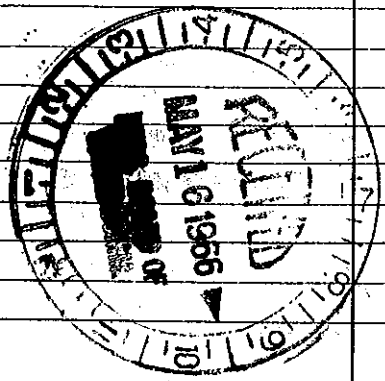

Well No. _____

(Use Back Side)

Retain this copy for your office files.