

CLAY
H III
9-67

MISSISSIPPI BOARD OF WATER COMMISSIONERS

WATER WELL DRILLERS LOG

CODED

Date: 9-15, 1967, Driller: Horton-Homan Well & Supply, Inc.
(When well drilled) P. O. Box 42 County Clay
SEANON, MISSISSIPPI 39088 Where well is located

(1) Owner of Land:	Description & Color of Materials Sand, Clay, Red Clay, Shell, etc.	Thick- ness Feet	Depth Feet
<u>49416 44</u> <u>Irene Burnett</u> <small>(Name)</small> <u>West Point Miss.</u> <small>(Address)</small> <u>NW NE</u>	<u>surface sand</u> <u>+ clay</u>	<u>0</u>	<u>28</u>
(2) Location: <u>1/4, NE 1/4, Sec. 24 T16R6E</u> <u>4</u> miles <u>NE</u> , of <u>West Point</u> <small>(distance) (direction) (Nearest Town)</small>	<u>blue clay</u> <u>sand</u> <u>bottom</u>	<u>28</u> <u>280</u> <u>400</u>	<u>280</u> <u>400</u>
(3) Topography: <u>Flat</u> <small>(Hilly) (Flat) (Level)</small>			
(4) Purpose of Well: <u>Home</u> <small>(Domestic Irrigation Municipal, Industrial, Other)</small>			

Information upon completion of well:

(1) Diameter 5 inches.

(2) Total Depth 400 feet.

(3) Water Level 80 feet below top of ground.

(4) Cased to 30' 7", Size 5"

(5) Screen: Size NONE, Length _____

(6) Were any formations sealed against pollution?
 yes, no.

CODED

If YES depth of formation _____


Why _____

Drillers Remarks: _____

Yield in gpm: 5

Size pump: 1/3 sub.

Type power: electric

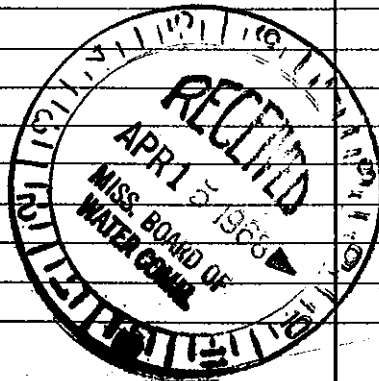

Mail this copy to Board of Water Commissioners 429 Miss. St. Jackson, Miss.