

CLAY MISSISSIPPI BOARD OF WATER COMMISSIONERS

H 112
12-18-63

WATER WELL DRILLERS LOG

CODED

PERKINSON WELL & SUPPLY CO.

Date: Dec 18, 1963, Driller: PERKINSON P.O. BOX 42 County Clay
(Name) MISSISSIPPI

4996078

(1) Owner of Land:	Description & Color of Materials Sand, Clay, Red Clay, Shell, etc.	Thick- ness Feet	Depth Feet
<i>Contractor</i> D. A. <u>2nd</u> <u>DR.</u> <u>DR.</u> (Name) <u>CAMP</u> <u>Job</u> <u>West Point Miss</u> (Address)	<u>surface sand</u> <u>& clay</u>		<u>0</u>
(2) Location: <u>SW 1/4, NW 1/4, Sec. 8</u> <u>T. 175 N</u> <u>R. 6 E</u> <u>2</u> miles <u>W</u> of <u>West Point</u> (distance) (direction) (Nearest Town)	<u>Flint rock</u> <u>&</u> <u>sand</u>		<u>18</u> <u>280</u>
(3) Topography: <u>Flat</u> (Hilly) (Flat) (Level)	<u>&</u>		
(4) Purpose of Well: <u>Domestic</u> (Domestic Irrigation Municipal, Industrial, Other)	<u>rock</u> <u>&</u> <u>sand</u>		<u>343</u> <u>344</u>

Information upon completion of well:


- (1) Diameter 4 inches.
- (2) Total Depth 400 feet.
- (3) Water Level 20 feet below top of ground.
- (4) Cased to 21'4", Size 4"
- (5) Screen: Size —, Length —
- (6) Were any formations sealed against pollution?
 yes, no.

If YES depth of formation 18

Why surface & sand

Drillers Remarks:

CODED

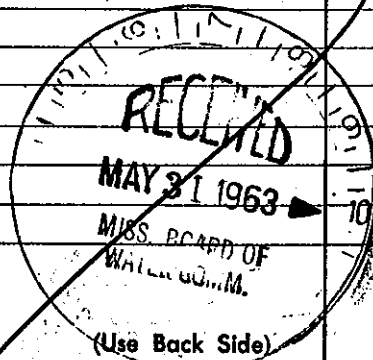

Well No.

Mail this copy to Board of Water Commissioners 429 Miss. St. Jackson, Miss.