

CLAY MISSISSIPPI BOARD OF WATER COMMISSIONERS

H113

WATER WELL DRILLERS LOG

CODED

12-18-63

Date: Dec. 18, 1963, Driller: SHANNON WELL & SUPPLY CO. County: Clay

4943794

P.O. BOX 42
SHANNON, MISSISSIPPI

(1) Owner of Land:	Description & Color of Materials Sand, Clay, Red Clay, Shell, etc.	Thick- ness Feet	Depth Feet
(Name) <u>J. H. Forrest</u> (Address) <u>West Point Miss</u>	<u>surface sand & clay</u>		<u>0</u>
(2) Location: <u>NE 1/4, NE 1/4, Sec. 8 T12R6E</u> <u>2</u> miles <u>W</u> , of <u>West Point</u> (distance) (direction) (Nearest Town)	<u>Blue rock</u>		<u>18</u>
(3) Topography: <u>Flat</u> (Hilly) (Flat) (Level)	<u>sand</u>	<u>8</u>	<u>275</u>
(4) Purpose of Well: <u>Domestic</u> (Domestic Irrigation Municipal, Industrial, Other)	<u>rock</u>	<u>8</u>	<u>350</u>
	<u>sand</u>	<u>8</u>	<u>357</u>
	<u>Bottom</u>		<u>400</u>

Information upon completion of well:


- (1) Diameter 4 inches.
- (2) Total Depth 400 feet.
- (3) Water Level 70 feet below top of ground.
- (4) Cased to 20' 4" Size 4"
- (5) Screen: Size —, Length —
- (6) Were any formations sealed against pollution?
 yes, no.

If YES depth of formation 18

Why surface & sand

Drillers Remarks:

CODED

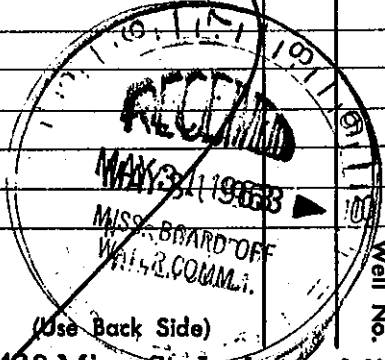

Well No.

(Use Back Side)

Mail this copy to Board of Water Commissioners 429 Miss. St. Jackson, Miss.