

H 114

12-28-63

WATER WELL DRILLERS LOG


CODED

HERNDON WELL & SUPPLY CO.

Date: Dec 28, 1963, Driller: P.O. BOX 42 County: CLAY

W. 494740 SHANNON, MISSISSIPPI

Contractor	Description & Color of Materials Sand, Clay, Red Clay, Shell, etc.	Thick- ness Feet	Depth Feet
(1) Owner of Land: J. H. Boggs, Jr. (Name)	surface sand		0
West Point, Miss. (Address)	clay		
(2) Location: White Sulphur Springs, Miss. 1/4, 1/4, Sec. 8, T. 175 N, R. 10 E	Blue sand		18
2 miles W, of West Point (distance) (direction) (Nearest Town)	Sand		280
(3) Topography: Flat (Hilly) (Flat) (Level)	Sand		340
(4) Purpose of Well: Domestic (Domestic Irrigation, Municipal, Industrial, Other)	Sand		391
Information upon completion of well:	Bottom		400

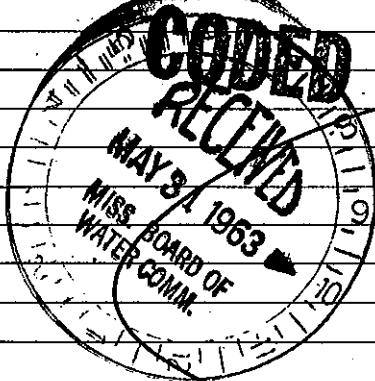

(1) Diameter 4 inches.

(2) Total Depth 400 feet.

(3) Water Level 70 feet below top of ground.

(4) Cased to 21', Size 4"

(5) Screen: Size —, Length —

(6) Were any formations sealed against pollution?
 yes, no.

If YES depth of formation 18 ft.

Why surface & sand

Drillers Remarks:

Well No.

(Use Back Side)

Mail this copy to Board of Water Commissioners 429 Miss. St. Jackson, Miss.