

CLAY
H115

MISSISSIPPI BOARD OF WATER COMMISSIONERS

WATER WELL DRILLERS LOG

CODED

12-18-63

Date: Apr 16, 1963, Drilled by HERNDON WELL & SUPPLY CO. County Clay

4943868

P. O. BOX 42
BRANNON, MISSISSIPPI

Contractor	Description & Color of Materials Sand, Clay, Red Clay, Shell, etc.	Thick- ness Feet	Depth Feet
(1) Owner of Land: <u>J. K. Bygones, Jr.</u> (Name) <u>LESTER Clayton Job, West Point, Miss</u> (Address)	<u>Surface sand</u>		<u>0</u>
(2) Location: <u>NW 1/4, NW 1/4, Sec. 4, T. 175, R. 6E</u> <u>2</u> miles <u>W</u> , of <u>West Point</u> (distance) (direction) (Nearest Town)	<u>Blue rock</u>		<u>30</u>
(3) Topography: <u>Flat</u> <u>NOT IN USE</u> (Hilly) (Flat) (Level)	<u>sand</u>		<u>280</u>
(4) Purpose of Well: <u>Domestic</u> (Domestic Irrigation Municipal, Industrial, Other)	<u>rock</u>		<u>350</u>
	<u>sand</u>		<u>351</u>
	<u>to</u>		
	<u>Bottom</u>		<u>400</u>

Information upon completion of well:


- (1) Diameter 4 inches.
- (2) Total Depth 400 feet.
- (3) Water Level 90 feet below top of ground.
- (4) Cased to 34' 4", Size 4".
- (5) Screen: Size _____, Length _____.
- (6) Were any formations sealed against pollution?
yes, _____ no.

If YES depth of formation 30'

Why Surface & sand

Drillers Remarks:

CODED

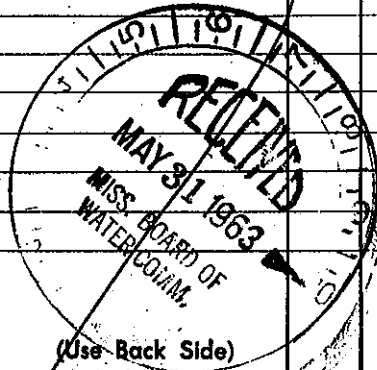

Well No.

(Use Back Side)

Mail this copy to Board of Water Commissioners 429 Miss. St. Jackson, Miss.