County: Clay
Permit #:
Driller: TARKS + PARKS
Date drilling completed: 8/10/07

State Well Report

Part 1 – Driller's Log

Mississippi Department of Environmental Quality
Office of Land and Water Resources
P.O. Box 10631
Jackson, MS 39289-0631
(601)961-5210

(601)354-6938 (fax)

For Office Use Only:
Aquifer:
Well #:
L. S. Elevation:
E-log #:

State Law requires that this report be prepared by the license holder responsible for the work and filed with the Department at the above address within 30 days of completion of drilling of the well or borehole.

Department at the above address within 50 days of comp	neuon of arming of the well or porenote.		
Information on Well Owner	Well or Borehole Location		
(Landowner if borehole is not for a water well)	Takinda 0 2 27 4 1 0		
Owner Name TRANK HOADER	Latitude:°, Longitude:°, "		
Mailing Address: P.O. Box 816	Method of Lat/Long (circle one): Conventional Survey,		
· · · · / / · · · / · · · · · · · · · ·	USGS quad, Hand-held GPS, Survey-grade GPS		
West foint, ms 39773	SF 1/4 SE-1/4 Sec 25 Twn 175 Rng 06E		
City State Zip Code	Distance Direction Nearest Town, Miles of		
Telephone No. (662) 494-5955			
Well/Bore	hole Data		
Date drilling started: 8/10/0) Date drilling completed: 8/10/0) Hole depth: 330 Hole diameter:			
Location of the source of any surface water used for drilling: Method of dosing and volume of Chlorine used in drilling and development:			
Logs run (circle all applicable): No log run Electric Gamma Ray Density Sonic Neutron Other: Name of organization running log(s):			
Purpose of borehole (check one): Water Well Geotechnical/Geological Investigation Ground Source Heat Pump			
Seismic Survey Other (describe)			
Purpose of Well (check one): Home Industrial Public Supply Irrigation Fish Culture Other:			
If a flowing well, method of flow regulation: Valve Other (describe)			
Static Water Level: 159 feet above or below (circle one) land surface Date measured: 8/13/67			
Method of Measurement (circle one) steel tape electric tape air line other:			
Well depth: 330 Well grouted to a depth of 50 feet Type of grout (circle of e): Neat Cement Bentonite Mix			
Casing length: 270 feet Casing diameter: 4 inches Type of casing: PIC			
Screen length: 60 feet Screen diameter: 4 inches Type of screen: PVC			
Screen slot size: .012 inches Setting depth: From 270 feet to 330 feet			
Type of completion (circle all applicable): Gravel packed Underreamed Telescoped Open hole Natural Development			
Other (describe):			
Top of lap pipe or reduction in casing:feet. If teles	scoped or more than one screen, describe on next page		

Form: OLWR-SWR-1A
RECEIVED

AUG 27 2007


BY: OLWA

If well telescopes, show depths on sketch. Ground Level. 50'- Coma

Description of Formations Encountered	From (depth)	To (depth)
	Ground Level	
Lime STONE SAND Clay + SAND SAND	0	142
SAND	142	183
Clay + SANO	183	287
SAND	187	330
		1

		<u> </u>
		<u> </u>
		<u> </u>
	L	L

If more than one screen, show location of each on sketch

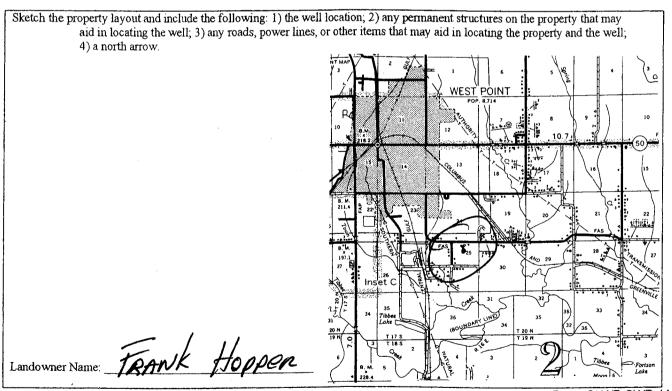

Form: OLWR-SWR-1A

I certify that the well/borehole was drilled, constructed, and completed in accordance with all applicable requirements of the Mississippi Department of Environmental Quality and the Mississippi Department of Health regulations, if applicable, and state

Print Name of Responsible Licensee and License No.

Signature of Licens RECEIVED

AUG 27 2007

BY: OLWR

STATE WELL REPORT Part 2

County: C/Ay Date completed: 8/10/0

Pump Installer's Completion Report Mississippi Department of Environmental Quality

Office of Land and Water Resources P.O. Box 10631 Jackson, MS 39289-0631 (601)961-5210 (601)354-6938 (fax)

For Office Use Only:		
Aquifer:		
Well #:		
Elevation:		

Copy information from block on Part 1	4-0530 (lax)			
This part of the report must be completed by a licensed water well contractor or a licensed pump installer. A copy of Part 1 of the report must be attached and both parts filed with the Department at the above address within 30 days of well completion.				
Well Owner Information	Well Location			
Well Owner Information	Well Location			
Owner Name: TRANK TOPPER	Latitude:Longitude:			
Mailing Address: 10, 80 8/6	Method of Lat/Long (check one): Conventional Survey,			
West toiNTMS35723	USGS quad, Hand-held GPS, Survey-grade GPS			
	SF 4 SF 4 Sec T 175 R 16F			
City State Zip Code	Distance Direction Nearest Town			
Telephone No. (66) 494-5955	2 Miles SE of West toint			
Pump Type	Power Type			
Circle one	Circle one			
Air Lift Jet Submersible	Diesel Engine Gasoline Engine Natural Gas			
Bucket Piston Turbine (Electric Motor Hand Tractor PTO			
Centrifugal Rotary Flowing Well	Windmill Other (specify):			
Other (specify):	Horse Power Rating of Motor:SHA			
Date Pump Installed: 8/12/07	Setting Depth:feet			
Rated Pump Capacity:Gallons Per Minute	Number of Stages: 26			
Pump Test Data	Method of Measuring Water Level			
	Circle one			
Date Well Tested: 8/12/67				
Static Water Level (A):Feet Below Land Surface	Air Line Electric Measuring Line Steel Tape			
Pumping Water Level (B): 200 Feet Below Land Surface	Other (specify):			
Drawdown [(B) – (A)]: 4/ Feet Below Land Surface	For flowing well, measured shut in head:feet			
Test Pumping Rate: Gallons Per Minute	Well yieldedGPM with a drawdown of			
Duration of Pump Test (minimum 4 hours):hours	feet afterhours of pumping			
Y YEAR DON'T OF THE PARTY OF TH	Emy Impuladas			
I HEREBY GERTIFY that the above statements are true to the best of	my Miowicako.			
KAULURN TARKS 0-414	6 Kaybundah			
Print Name of Pump Installer and License No. (if applicable)	Signature of Pump Installer			
	FRECEPVED			

AUG 27 2007

BY: OLWR