

CLAY

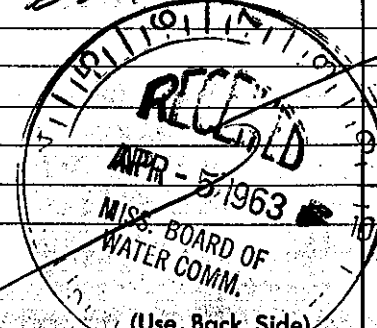
H 2000

9-22-62

MISSISSIPPI BOARD OF WATER COMMISSIONERS

WATER WELL DRILLERS LOG

Date: Sept 22, 1962, Driller: HERNDON WELL & SUPPLY CO. P.O. BOX 42 SHANNON, MISSISSIPPI County: Clay

	Description & Color of Materials Sand, Clay, Red Clay, Shell, etc.	Thick- ness Feet	Depth Feet			
(1) Owner of Land: <u>Contractor</u> <u>O. H. Stephens</u> (Name) <u>West Point, Mississippi</u> (Address) <u>Box 006</u> (P.O. Box) <u>9 T. R. 6 E</u> (Section)	Surface sand & clay		0			
(2) Location: $\frac{1}{4}$, $\frac{1}{4}$, Sec. <u>9</u> T. <u>17</u> S. R. <u>6</u> E <u>2</u> miles <u>W</u> , of <u>West Point</u> (distance) (direction) (Nearest Town)	Sand Blue sand		5 25			
(3) Topography: <u>Flat</u> (Hilly) (Flat) (Level)	Sand Rock		5 100			
(4) Purpose of Well: <u>Domestic</u> (Domestic Irrigation Municipal, Industrial, Other)	Sand Blue sand		5 101			
Information upon completion of well:						
(1) Diameter: <u>4</u> inches.	Rock		120			
(2) Total Depth: <u>400</u> feet.	Blue Rock		121			
(3) Water Level: <u>50</u> feet below top of ground.	Sand		255			
(4) Cased to <u>29' 6"</u> , Size <u>4 in</u>	Rock		260			
(5) Screen: Size <u>—</u> , Length <u>—</u>	Sand		251			
(6) Were any formations sealed against pollution?	Rock		350			
<input checked="" type="checkbox"/> yes, <input type="checkbox"/> no.	Sand		351			
If YES depth of formation: <u>25 ft.</u>	Bottom		400			
Why: <u>Surface & sand</u>						
Drillers Remarks:						

Well No.

Mail this copy to Board of Water Commissioners 429 Miss. St. Jackson, Miss.