

Clay  
H 200  
7-68

MISSISSIPPI  
BOARD OF WATER COMMISSIONERS  
416 North State Street  
Jackson, Mississippi 39201

WATER WELL DRILLERS LOG

7/30 1968 Herndon-Homan Well & Supply, Inc. *Clay*  
date well completed P. O. Box 42 county well located  
**SHANNON, MISSISSIPPI 38868**


LANDOWNER:  
*S. H. Bryan (contractor)*  
*West Point, Miss*  
(mailing address)

description of formations encountered	from	to
<i>Surface sand</i>	<i>0</i>	<i>18</i>
<i>Clay</i>	<i>18</i>	<i>220</i>
<i>Blue clay</i>	<i>220</i>	<i>340</i>
<i>Gravel</i>	<i>340</i>	<i>340</i>
<i>Bottom</i>	<i>340</i>	

WELL LOCATION:  
sec. *8* T. *20* N. R. *6* E  
*2* miles *W* of *West Point*  
(distance) (direction) (nearest town)

WELL PURPOSE: *Home*  
(home, irrigation, municipal, industrial)

- WELL COMPLETION DATA:
- (1) diameter (inches) *4"*
  - (2) total depth (feet) *340'*
  - (3) static water level (feet) *60'* below top of ground.
  - (4) casing *Steel*, *22'4"*  
(material) (depth)  
*4"* If telescope see back.  
(size)
  - (5) screen *20'*,  
(length) (depth to top)  
(size) (material)
  - (6) pump *3/4* *4*  
(HP) (yield gpm)  
*electric*  
(type power)
  - (7) electric log *no*  
(yes or no)  
(organization running log)
  - (8) how well bottom plugged *open*

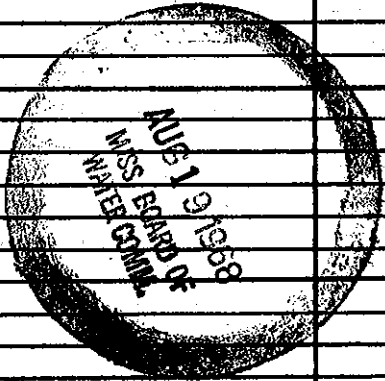

DRILLERS REMARKS: