

CLAY

J 69

9-27-62

MISSISSIPPI BOARD OF WATER COMMISSIONERS

WATER WELL DRILLERS LOG

CODED

Date: Sept 27, 1962, Driller: HERNDON WELL & SUPPLY CO. County Clay
P. O. BOX 42
(Name)
SHANNON, MISSISSIPPI

(1) Owner of Land:	Description & Color of Materials Sand, Clay, Red Clay, Shell, etc.	Thick- ness Feet	Depth Feet
<u>Scott Gibbs</u> <small>(Name)</small> <u>Rt 2 West Point, Miss</u> <small>(Address)</small>	<u>Surface sand</u> <u>& clay</u>		<u>0</u>
(2) Location: <u>SW SESE</u> <small>1/4, 1/4, Sec 20 T 17 S R 10 E</small> <u>4</u> miles <u>E</u> , of <u>West Point</u> <small>(distance) (direction) (Nearest Town)</small>	<u>Blue rock</u> <u>&</u> <u>sand</u>		<u>20</u> <u>170</u>
(3) Topography: <u>Flat</u> <small>(Hilly) (Flat) (Level)</small>	<u>&</u>		
(4) Purpose of Well: <u>Domestic</u> <small>(Domestic Irrigation Municipal, Industrial, Other)</small>	<u>Bottom</u>		<u>240</u>

Information upon completion of well:


- (1) Diameter 4 inches.
- (2) Total Depth 240 feet.
- (3) Water Level 70 feet below top of ground.
- (4) Cased to 21'4", Size 4".
- (5) Screen: Size , Length .
- (6) Were any formations sealed against pollution?
 yes, no.

If YES depth of formation 20'

Why Surface & sand

Drillers Remarks: Elev. ± 210
at top 20'

CODED

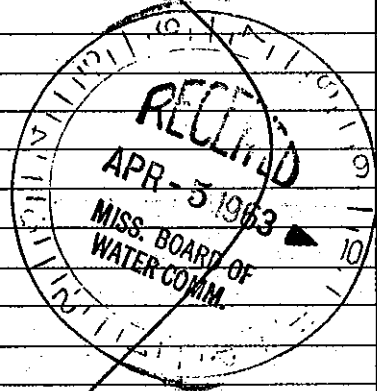

Well No.

(Use Back Side)

Mail this copy to Board of Water Commissioners 429 Miss. St. Jackson, Miss