

CLAY
J70
7-67

MISSISSIPPI BOARD OF WATER COMMISSIONERS

CODED

WATER WELL DRILLERS LOG

Date: 7-28, 1967, Driller: Merndon-Human Well & Supply Co.
(When well drilled) (Name) (Where well is located)

SHANNON, MISSISSIPPI 38868

		Description & Color of Materials Sand, Clay, Red Clay, Shell, etc.	Thick- ness Feet	Depth Feet
1) Owner of Land:	<u>W. Mitchell</u> (Name) <u>Rt 2 West Point, Miss</u> (Address)	<u>Surface sand & clay</u>	<u>0</u>	<u>20</u>
2) Location:	<u>NE 1/4, NW 1/4, Sec. 33 T17R7E</u> <u>4</u> miles <u>SE</u> of <u>West Point</u> (distance) (direction) (Nearest Town)	<u>Blue clay</u>	<u>20</u>	<u>140</u>
		<u>sand</u>	<u>140</u>	<u>280</u>
		<u>Bottom</u>	<u>280</u>	
3) Topography:	<u>Flat</u> (Hilly) (Flat) (Level)			
4) Purpose of Well:	<u>Home</u> (Domestic Irrigation Municipal, Industrial, Other)			


Information upon completion of well:

- 1) Diameter 4 inches.
- 2) Total Depth 280 feet.
- 3) Water Level 20 feet below top of ground.
- 4) Cased to 24', Size 4"
- 5) Screen: Size ND, Length _____
- 6) Were any formations sealed against pollution?
 yes, _____ no.

If YES depth of formation 20
Why Surface & sand

Drillers Remarks: Elev. 1220
at top 20'
Yield in gpm: Hand pump
Size pump: _____
Type power: _____

CODED

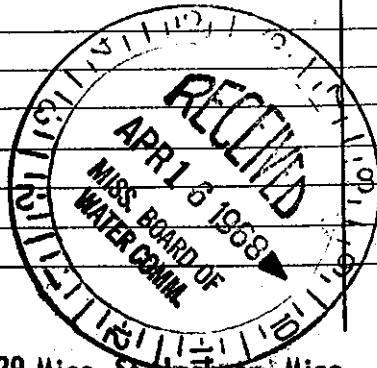

Mail this copy to Board of Water Commissioners 429 Miss. St. Jackson, Miss.