

CLAY  
571  
9-66

MISSISSIPPI BOARD OF WATER COMMISSIONERS

WATER WELL DRILLERS LOG

**CODED**

Date: Sept 13, 1966, Driller: Herndon-Hosman Well & Supply, Inc.  
(When well drilled) P. O. Box 42 County Clay  
SHANNON, MISSISSIPPI 38868 (Where well is located)


(1) Owner of Land: KRMA SWAINS  
(Name)  
Rt 2 West Point, Miss.  
(Address)  
(2) Location: NE 1/4, NE 1/4, Sec. 33, T. 17 S., R. 10 E.  
4 miles SE, of West Point  
(distance) (direction) (Nearest Town)  
(3) Topography: Flat  
(Hilly) (Flat) (Level)  
(4) Purpose of Well: Domestic  
(Domestic Irrigation  
Municipal, Industrial, Other)

Description & Color of Materials Sand, Clay, Red Clay, Shell, etc.	Thick- ness Feet	Depth Feet
Surface sand		
Clay	0	30
Blue clay	30	240
Sand	240	360
Bottom	360	

Information upon completion of well:

(1) Diameter 4 inches.  
(2) Total Depth 360 feet.  
(3) Water Level 60 feet below top of ground.  
(4) Cased to 34', Size 4"  
(5) Screen: Size NONE, Length \_\_\_\_\_  
(6) Were any formations sealed against pollution?  
✓ yes, \_\_\_\_\_ no.  
If YES depth of formation 30'  
Why surface + sand  
Drillers Remarks: Hand pump  
Yield in gpm: Elev. ±225  
at 10' to 20'  
Size pump: \_\_\_\_\_  
Type power: \_\_\_\_\_

**CODED**

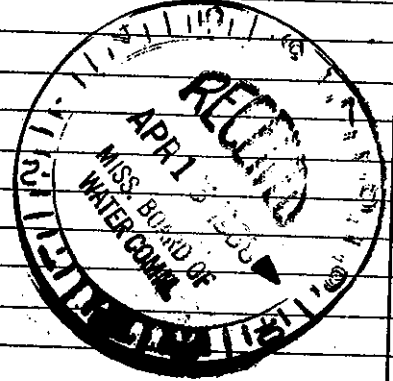

Mail this copy to Board of Water Commissioners 429 Miss. St. Jackson, Miss.