

CLAY

573

9-66

MISSISSIPPI BOARD OF WATER COMMISSIONERS
416 North State Street
Jackson, Mississippi 39201

CODED

WATER WELL DRILLERS LOG

Sept 22 1966 date well completed
Hernon-Noman Well & Supply, Inc. firm name
P.O. Box 42
SWANNON, MISSISSIPPI 38868 county well located

LANDOWNER:

A.C. Cox

At 2 West Point, Miss.
(mailing address)

WELL LOCATION:

sec 33 T 19 N R 7 E
S W
9 miles SE of West Point
(distance) (direction) (nearest town)

WELL PURPOSE:

Home
(home, irrigation, municipal, industrial)


WELL COMPLETION DATA:

- (1) diameter (inches) 4"
- (2) total depth (feet) 300'
- (3) static water level (feet) 18' below top of ground.
- (4) casing steel 18'6" (material) (depth)
No (size) if telescope see back.
- (5) screen none (length) (depth to top)
(size) (material)
- (6) pump HP (HP) (yield gpm)
(type power)
- (7) electric log NO (yes or no)
(organization running log)
- (8) how well bottom plugged open

description of formations encountered

description of formations encountered	from	to
surface sand		
clay	0	16
Blue clay	16	180
Sand	180	300
Bottom	300	

CODED

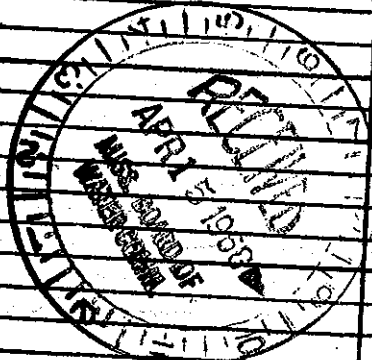

DRILLERS REMARKS: Elev. ± 190
est. depth 20'