

CLAY
JTB
9-65

MISSISSIPPI BOARD OF WATER COMMISSIONERS

CODED

WATER WELL DRILLERS LOG

Date: Sept. 13, 1965, Driller: Hendon-Homan Well & Supply, Inc.
(When well drilled) P. O. Box 42 County W/As
BEAUMONT, MISSISSIPPI 38866 Where well is located

(1) Owner of Land:	Description & Color of Materials	Thick-ness Feet	Depth Feet
<u>Henderson Cherry</u> (Name)	<u>surface sand</u>		
<u>Rt 2 West Point, Miss</u> (Address)	<u>clay</u>	<u>0</u>	<u>24</u>
(2) Location: <u>NE 1/4, NW 1/4, Sec 27 T. 17 S. R. 2 E</u>	<u>Blue clay</u>	<u>24</u>	<u>248</u>
<u>1/4 miles EAST of West Point</u> (distance) (direction) (Nearest Town)	<u>Sand</u>	<u>248</u>	<u>360</u>
(3) Topography: <u>Flat</u> (Hilly) (Flat) (Level)	<u>Bottom</u>	<u>360</u>	
(4) Purpose of Well: <u>Domestic</u> (Domestic Irrigation, Municipal, Industrial, Other)			

Information upon completion of well:

(1) Diameter 4 inches.

(2) Total Depth 360 feet.

(3) Water Level 50 feet below top of ground.

(4) Cased to 26' 7", Size 4".

(5) Screen: Size NONE, Length _____.

(6) Were any formations sealed against pollution?
 yes, no.

If YES depth of formation 24'

Why surface & sand


Drillers Remarks: Hand pump

Yield in gpm: Elev ± 205
est. top 20

Size pump: _____

Type power: _____

CODED

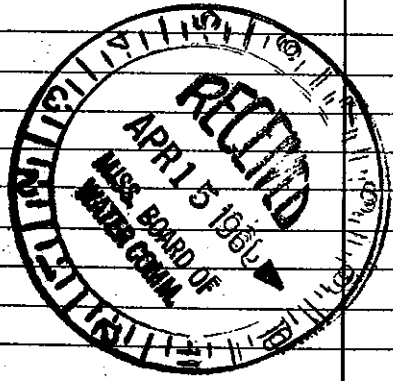

Mail this copy to Board of Water Commissioners 429 Miss. St. Jackson, Miss.