

CLAY
577
4-68

MISSISSIPPI
BOARD OF WATER COMMISSIONERS
416 North State Street
Jackson, Mississippi 39201

CODED

WATER WELL DRILLERS LOG

date well completed 4/12 1968 Herndon-Homan Well & Supply, B.G.S.
firm name Box 42 county well located
SHANNON, MISSISSIPPI 38868


LANDOWNER:
Eugene Pittman, Jr.
Rt 2 West Point, Miss.
(mailing address)

| description of formations encountered | from | to |
|---------------------------------------|------------|------------|
| <u>Surface clay</u> | <u>0</u> | <u>30</u> |
| <u>Blue Rock</u> | <u>30</u> | <u>240</u> |
| <u>Sand</u> | <u>240</u> | <u>340</u> |
| <u>Gravel</u> | <u>340</u> | |

WELL LOCATION:
sec. 22 T. 17 N. R. 7 E.
4 miles SE of West Point
(distance) (direction) (nearest town)

WELL PURPOSE: Home
(home, irrigation, municipal, industrial)

- WELL COMPLETION DATA:
- (1) diameter (inches) 5
 - (2) total depth (feet) 340
 - (3) static water level (feet) 50 below above top of ground.
 - (4) casing Steel 24 5/8"
(material) (depth)
5 if telescope see back.
(size)
 - (5) screen NO
(length) (depth to top)
(size) (material)
 - (6) pump 3/4 5
(HP) (yield gpm)
electric
(type power)
 - (7) electric log NO
(yes or no)
(organization running log)
 - (8) how well bottom plugged Open

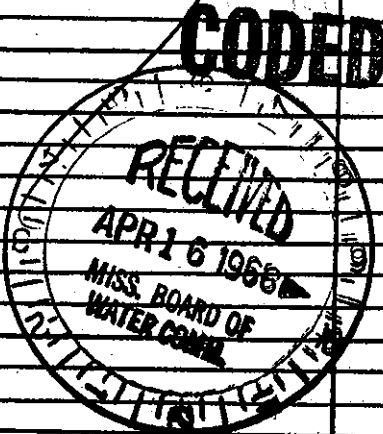

DRILLERS REMARKS: St. loc. ± 205
est. topo. 20'