

CLAY  
578  
8-67

MISSISSIPPI BOARD OF WATER COMMISSIONERS

WATER WELL DRILLERS LOG

**CODED**

Date: 8-31-1967 Driller: Hornsten-Homan Well & Supply, Inc. County: CLAY  
(When well drilled) P. O. Box 42  
SHANNON, MISSISSIPPI 38608 (Where well is located)

(1) Owner of Land	Description & Color of Materials	Thick-ness Feet	Depth Feet
<u>Charles Edwards</u> (Name) <u>Rt 2 West Point, Miss.</u> (Address) <u>NE 1/4, NE 1/4, Sec. 21, T. 15, R. 7E</u> (Location) <u>4</u> miles <u>SE</u> of <u>West Point</u> (distance) (direction) (Nearest Town) <u>flat</u> (Hilly) (Flat) (Level) <u>Home</u> (Domestic Irrigation) (Municipal, Industrial, Other)	<u>surface clay &amp; sand</u> <u>blue clay</u> <u>sand</u> <u>bottom</u>	<u>0-27</u> <u>27-220</u> <u>220-340</u> <u>340</u>	

Information upon completion of well:

- (1) Diameter 5 inches.
- (2) Total Depth 340 feet.
- (3) Water Level 51 feet below top of ground.
- (4) Cased to 30', Size 5"
- (5) Screen: Size NONE, Length \_\_\_\_\_
- (6) Were any formations sealed against pollution?  
 yes, \_\_\_\_\_ no.

If YES depth of formation 27'

Why surface + sand


Drillers Remarks: Elev. ± 215  
Lat. + 20'

Yield in gpm: 5

Size pump: 3/4 HP Jet

Type power: electric

**CODED**

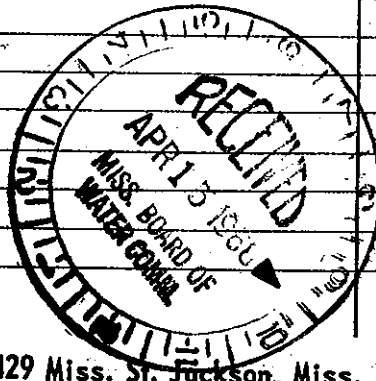

Mail this copy to Board of Water Commissioners 429 Miss. St. Jackson, Miss.