

CLAY

MISSISSIPPI BOARD OF WATER COMMISSIONERS

J79

3-24-61

WATER WELL DRILLING

CODED

J-300

HERNDON WELL & SUPPLY CO.

Date: March 24, 1961, Driller: P. O. BOY 42 County Clay

SHANNON, MISSISSIPPI

(1) Owner of Land: <u>Charles Shelton Sr.</u> (Name)	Description & Color of Materials Sand, Clay, Red Clay, Shell, etc.	Thick- ness Feet	Depth Feet
<u>West Point, Miss</u> (Address)	<u>Sand & clay</u> <u>Blue silt</u>		<u>20</u>
(2) Location: <u>SW 1/4, SW 1/4, Sec. 12 T17R7E</u> <u>3 miles East of West Point</u> (distance) (direction) (Nearest Town)	<u>Sand</u> <u>Bottom</u>	<u>1.00</u>	<u>220</u>
(3) Topography: <u>Flat</u> (Hilly) (Flat) (Level)			
(4) Purpose of Well: <u>Home</u> (Domestic Irrigation Municipal, Industrial, Other)			

Information upon completion of well:


CODED

- (1) Diameter 4 inches.
- (2) Total Depth 220 feet.
- (3) Water Level 60' feet below top of ground.
- (4) Cased to 22', Size 4"
- (5) Screen: Size —, Length —
- (6) Were any formations sealed against pollution?
 yes, no.

If YES depth of formation 20'

Why Subsoil & Sand

Drillers Remarks: Elev. ±220
at top 20'

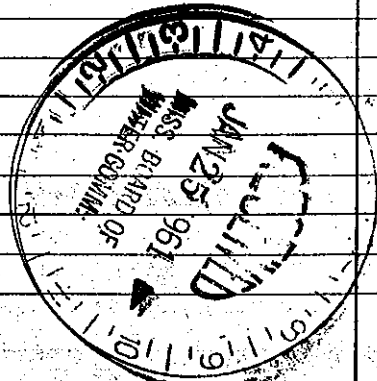

(Use Back Side)

Well No

Mail this copy to Board of Water Commissioners 429 Miss. St. Jackson, Miss