

CLAY
J 80
4-66

MISSISSIPPI BOARD OF WATER COMMISSIONERS

CODED

WATER WELL DRILLERS LOG

Date April 23, 1966, Driller Harmon Norman Well & Supply Co. Inc.
(When well drilled) Box 42 (Where well is located)
Stanton, Mississippi 38660

(1) Owner of Land: A. C. Spaulding
(Name)

St 2 West Point Miss.
SW NW (Address) 25 16 5

(2) Location: 1/4, 1/4, Sec 25 T 16 S R 7 E
6 miles E of West Point
(distance) (direction) (Nearest Town)

(3) Topography: Flat
(Hilly) (Flat) (Level)

(4) Purpose of Well: Domestic
(Domestic Irrigation, Municipal, Industrial, Other)

Description & Color of Materials
Sand, Clay, Red Clay, Shell, etc.

Description & Color of Materials	Thick-ness Feet	Depth Feet
<u>Surface sand</u>	<u>0</u>	<u>60</u>
<u>& clay</u>	<u>60</u>	<u>120</u>
<u>Blue Clay</u>	<u>100</u>	<u>220</u>
<u>Sand</u>	<u>100</u>	<u>220</u>
<u>Bottom</u>	<u>220</u>	

Information upon completion of well:

(1) Diameter 4 inches.

(2) Total Depth 220 feet.

(3) Water Level 85.4 feet below top of ground.

(4) Cased to 2' 8", Size 4"

(5) Screen: Size NONE, Length _____

(6) Were any formations sealed against pollution?
yes, _____ no.

If YES depth of formation 60'

Why Surface & sand


Drillers Remarks: no pump installed

Yield in gpm: _____
Elev. ±250
stat. top of 20'

Size pump: _____

Type power: _____

CODED

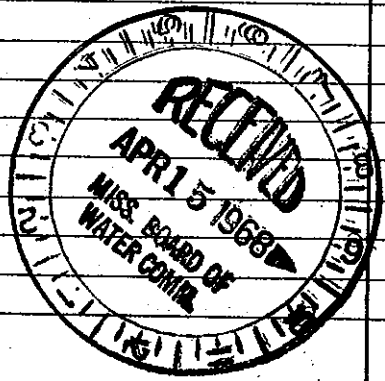

Mail this copy to Board of Water Commissioners 429 Miss. St. Jackson, Miss.