

CLAY
J81
8-67

MISSISSIPPI BOARD OF WATER COMMISSIONERS

WATER WELL DRILLERS LOG

CODED

Marston-Roman Well & Supply, Inc.

Date: 8-12, 1967, Driller: SEANNON, MISSISSIPPI 38668 P. O. Box 42 County Clay
(When well drilled) (Name) (Where well is located)

(1) Owner of Land: Eld Sanders
(Name)
At 2 West Point, Miss
SW NWSW (Address)
(2) Location: 1/4, 1/4, Sec. 24, 16 S.
1/4, 1/4, Sec. 24, 16 S.
6 miles E, of West Point
(distance) (direction) (Nearest Town)
(3) Topography: Flat
(Hilly) (Flat) (Level)
(4) Purpose of Well: Home
(Domestic Irrigation
Municipal, Industrial, Other)


Description & Color of Materials Sand, Clay, Red Clay, Shell, etc.	Thick- ness Feet	Depth Feet
<u>Surface sand & clay</u>		<u>0 65</u>
<u>3" thin clay</u>		<u>65 (20)</u>
<u>Sand</u>		<u>(20) 220</u>
<u>Bottom</u>		<u>220</u>

Information upon completion of well:

(1) Diameter 4 inches.
(2) Total Depth 220 feet.
(3) Water Level 4' 82.84 feet below top of ground.
(4) Cased to 71', Size 4"
(5) Screen: Size None, Length _____
(6) Were any formations sealed against pollution?
✓ yes, _____ no.

If YES depth of formation 65'
Why Surface & Sand
Drillers Remarks: Elev ± 250
at top 20'
Yield in gpm: _____
Size pump: By others
Type power: _____

CODED

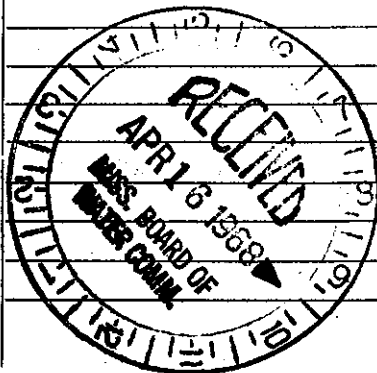

Mail this copy to Board of Water Commissioners 429 Miss. St. Jackson, Miss.