

Clay
 82
 7-68

MISSISSIPPI
 BOARD OF WATER COMMISSIONERS
 416 North State Street
 Jackson, Mississippi 39201

CODED

WATER WELL DRILLERS LOG

WATER WELL DRILLERS & Supply, Inc.
 P. O. Box 42
 SHANNON, MISSISSIPPI 38888

7-5 1968 date well completed
 SHANNON, MISSISSIPPI 38888 firm name
 Clay county well located

LANDOWNER:

H.G. Booker

description of formations encountered

Topsoil Band

from to

0 75

West Point Miss (mailing address)

Clay Band

75 120

WELL LOCATION:


sec. 36 T. 16 N. R. 7 E
 7 miles SIVE West Point (distance) (direction) (nearest town)

WELL PURPOSE: Home (home, irrigation, municipal, industrial)

WELL COMPLETION DATA:

- (1) diameter (inches) 4"
- (2) total depth (feet) 240'
- (3) static water level (feet) 81' below top of ground
- (4) casing Steel 82'5" (material) (depth)
 4" (size) if telescope see back.
- (5) screen NO (length) (depth to top)
- (6) pump 3/4 (HP) 5 (yield gpm)
 Electric (type power)
- (7) electric log NO (yes or no)
 (organization running log)
- (8) how well bottom plugged Open

CODED

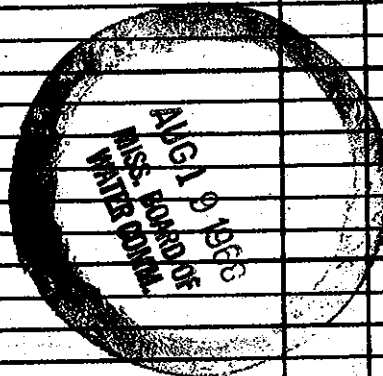

DRILLERS REMARKS: ±240 Elev. Mt. Cap. 20'