

CLAY
 Well No. III
~~U-155~~ 86
 7-71

MISSISSIPPI
 BOARD OF WATER COMMISSIONERS
 416 North State Street
 Jackson, Mississippi 39201

CODED

WATER WELL DRILLERS LOG

HERMAN ECHOLS

date well completed 19 71 ROUTE 1 name Clay
July N.W. 50E STARKVILLE MISS. county well located


LANDOWNER: George Bryan
Bryan Bros. 1940E
West Point, Miss
 (mailing address)

description of formations encountered	from	to
<u>Clay</u>	<u>0</u>	<u>10</u>
<u>Clay</u>	<u>10</u>	<u>174</u>
<u>Sand</u>	<u>174</u>	<u>300</u>

WELL LOCATION:
 sec. 8 T. 22 N. R. 7 E
4 miles West of West Point
 (distance) (direction) (nearest town)

WELL PURPOSE:
 (home, irrigation, municipal, industrial)

- WELL COMPLETION DATA:
- (1) diameter (inches) 5"
 - (2) total depth (feet) 300
 - (3) static water level (feet) 140 below above top of ground.
 - (4) casing 21 5"
 (material) (depth)
 (size) if telescope see back.
 - (5) screen _____
 (length) (depth to top)
 (size) (material)
 - (6) pump 2 20
 (HP) (yield gpm)
Elect.
 (type power)
 - (7) electric log _____
 (yes or no)
 (organization running log)
 - (8) how well bottom plugged _____

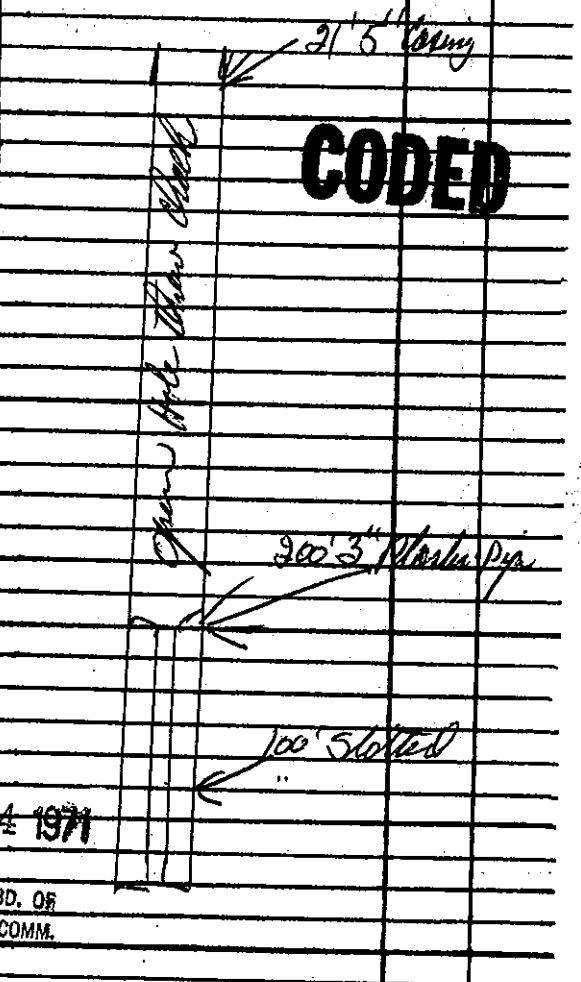

CODED

OCT 4 1971

DRILLERS REMARKS:
 MISS. BD. OF WATER COMM.