

CLAY MISSISSIPPI BOARD OF WATER COMMISSIONERS

J92
3-23-61

WATER WELL DRILLERS LOG
HERNDON WELL & SUPPLY

4-306
CODED

Date: March 23, 1961, Driller: SHANNON, MISSISSIPPI County Clay
(Name)

(1) Owner of Land:	Description & Color of Materials	Thick-ness Feet	Depth Feet
<u>JAMES Gibbs</u> (Name) 4946604 OLD WAVERLY RD <u>West Point</u> (Address)	<u>smalt clay</u> to		<u>13</u>
(2) Location: <u>SE 1/4, SE 1/4, Sec. 20, T15N, R10E</u> <u>1/2</u> miles <u>East</u> of <u>West Point</u> (distance) (direction) (Nearest Town)	<u>Blue rock</u> to <u>sand</u> to		<u>18</u> <u>200</u>
(3) Topography: <u>Flat</u> (Hilly) (Flat) (Level)	<u>Bottom</u>		<u>320</u>
(4) Purpose of Well: <u>Home</u> (Domestic Irrigation, Municipal, Industrial, Other)			

Information upon completion of well:


- (1) Diameter 4 inches.
- (2) Total Depth 320 feet.
- (3) Water Level 50 feet below top of ground.
- (4) Cased to 22', Size 4".
- (5) Screen: Size —, Length —.
- (6) Were any formations sealed against pollution?
✓ yes, — no.

CODED

If YES depth of formation 20'

Why Surface & Sand

Drillers Remarks:

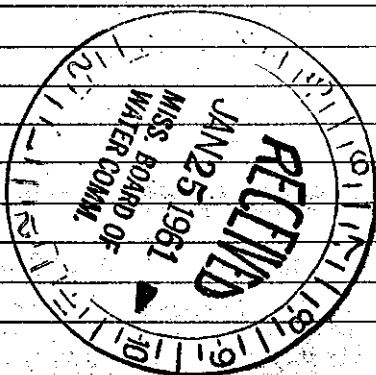

Well No.

(Use Back Side)

Mail this copy to Board of Water Commissioners 429 Miss. St. Jackson, Miss.