
s ., State W	lell Depent			
	For Office Use Only:			
	Iriller's LOG			
Mississippi Departmen	and Water Resources			
P.O. E	Box 10631			
Jackson, M	1S 39289-0631 L. S. Elevation: 961-5210			
	4-6938 (fax) E-log #:			
State Law requires that this report be prepared by the license holder responsible for the work and filed with the Department at the above address within 30 days of completion of drilling of the well or borehole.				
Information on Well Owner	Well or Borehole Location			
(Landowner if borehole is not for a water well)	Latitude: 33 ° 37 '904' Longitude 088 ° 30' 269			
Owner Name Urog Bernsbey	Method of Lat/Long (circle one): Conventional Survey, 16			
Mailing Address: 10598 Ruises Oaks Dr.	USGS quad, (Hand-held GPS) Survey-grade GPS			
	1/4 1/4 Sec 6 Twn 175 Rng 8E			
City State Zip Code	Distance Direction Nearest Town 6 2 Miles Cost of US. Point			
Telephone No. 228) 207 - 4154	672 Miles East of US. Point			
Well / Borehole Data				
Date drilling started: 12/127 Date drilling completed: 12/18/07 Hole depth: 142 Hole diameter:				
Method of dosing and volume of Chlorine used in drilling and development:				
Logs run (circle all applicable): No log run Electric Gamma Ray Density Sonic Neutron Other:				
Purpose of borehole (check one): Water Well V Geotechnical/Geological Investigation Ground Source Heat Pump				
Seismic SurveyOther (<i>describe</i>) If drilling is not related to water well construction, skip the remainder of this block				
Purpose of Well (check one): HomeIndustrial Public Supply Irrigation Fish Culture Other:				
If a flowing well, method of flow regulation: Valve Other (describe)				
Static Water Level:				
Method of Measurement (circle one) (steel tape) electric tape air line other:				
Well depth: 142 Well grouted to a depth of 2 Deet Type of grout (circle one): Neat Cement Bentonite Mix				
Casing length: <u>80</u> feet Casing diameter: <u>4</u> inches Type of casing: <u>PVC</u>				
Screen length: <u>40</u> feet Screen diameter: <u>a</u> inches Type of screen: <u>PVC</u>				
Screen slot size: ,013 inches Setting depth: From 102 feet to 142 feet				
Type of completion (circle all applicable): Gravel packed Underreamed Telescoped Open hole Natural Development				
Other (describe):				
Top of lap pipe or reduction in casing: <u>5</u> feet. If telescoped or more than one screen, describe on next page				

J155 Description of formations encountered must be provided for all wells and boreholes, unless specifically exempted by regulations Description of Formations Encountered From (depth) Ground Level andyria 8 darane \mathbf{x} Phine Clas amd

The sketch below only required for water wells

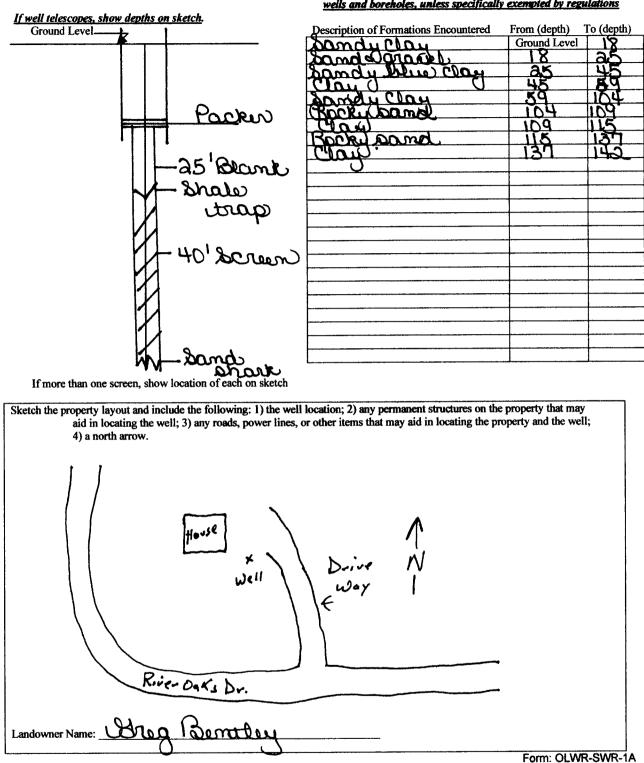

I certify that the well/borehole was drilled, constructed, and completed in accordance with all applicable requirements of the Mississippi Department of Environmental Quality and the Mississippi Department of Health regulations, if applicable, and state

laws. Donald B. Clardy 0-496 1/9/08 Schold Better

Print Name of Responsible Licensee and License No.

Signature of Licensee

STATE WELL REPORT				
County: <u>Clay</u> Permit #: Driller: <u>Clardy</u> Drill). Date completed: <u>1249</u> <u>Copy information from block on Part 1</u>	Part 2 Pump Installer's Completion Report Mississippi Department of Environmental Quality Office of Land and Water Resources P.O. Box 10631 Jackson, MS 39289-0631 (601)961-5210 (601)354-6938 (fax)		For Office Use Only: Aquifer: J 1 5 5 Well #:	
This part of the report must be completed by a licensed water well contractor or a licensed pump installer. A copy of Part 1 of the report must be attached and both parts filed with the Department at the above address within 30 days of well completion.				
Well Owner Informa	Well Owner Information		Location	
Owner Name: Lang Bem-	Latitude: N 33° 37.0		Longitude: WD88 30.46	
Mailing Address: 10598 Rui	en bake D Method of Lat/Long (check or		ne): Conventional Survey,	
			GPS Survey-grade GPS	
W. Point, M City State	15 39713 Zip Code	¼¼ Sec_6	T 175 R 85	
	HI54 Distance Direction Nearest Town		^ -	
Telephone No. (228 201 - L	1104	6 d Miles tasto	f_ULIVISAL	
Burne Terres		Po	wer Type	
Pump Type Circle one			ircle one	
Air Lift Jet	Submersible	Diesel Engine Gasolin	e Engine Natural Gas	
Bucket Piston	Turbine	Electric Motor Hand	Tractor PTO	
Centrifugal Rotary	Flowing Well	Windmill Other	(specify):	
Other (specify):		Horse Power Rating of Motor	1/2	
Date Pump Installed: 12 19 01		Setting Depth:	feet	
Rated Pump Capacity:		Number of Stages:		
Pump Test Data		Method of Measuring Water Level Circle one		
Date Well Tested: 12/19/5		Air Line Electric Mea	suring Line Steel Tape	
Static Water Level (A):	t Below Land Surface	Other (specify):		
Pumping Water Level (B):Fee	t Below Land Surface	Outer (specify)		
Drawdown [(B) - (A)]:Fee	t Below Land Surface	For flowing well, measured sl	hut in head:feet	
Test Pumping Rate:		Well yieldedGPM with a drawdown of		
Duration of Pump Test (minimum 4 hours		feet after	hours of pumping	
I HEREBY CERTIFY that the above state		(),105	4	

Donald B. Clardy D-496 Print Name of Pump Installer and License No. (if applicable)

.

†

.

Signature of Pump Installer

PECE /ED As 12 7% GN 225 72%

Form: OLWR-SWR-1B