
	State Well Report			
County: Clay	Part 1 – Driller's Log	For Office Use Only:		
•	Mississippi Department of Environmental Qua	lity Aquifer: <u>7/60</u>		
Permit #:	Office of Land and Water Resources P.O. Box 2309	Well #:		
Driller: Clardy	Jackson, MS 39225	L. S. Elevation:		
Date drilling completed:	(601)961- 5210 (601)061 - 5228 (fax)			
	(601)961- 5228 (fax)	E-log #:		
State Law requires that this repor	t be prepared by the license holder responsible	e for the work and filed with the		
Department at the above address Information on Well C	within 30 days of completion of drilling of the	D L.I.T		
(Landowner if borehole is not fo	ar a water well	29 W 04		
Owner Name John Son	Latitude: 33°37	' Gent" Longitude: 088 30' DH "		
N	∧ ∩ I Method of Lat/Long (ci	rcle one): Conventional Survey,		
Mailing Address: 1300 20	mayland	d-held GPS, Survey-grade GPS		
Core	5			
	M & 2070 2 5 1/2 1/4 Sec	0 Twn 175 Rng 7E		
L. Point City Stat	tion Nearest Town			
-	· · · · · · · · · · · · · · · · · · ·	tion Nearest Town of West Point MS		
Telephone No. (228 217 - 2		r		
	Well / Borehole Data			
Date drilling started: 4/2/11 Date dri	Illing completed: 4/21/11 Hole depth: 155	Hole diameter:		
Location of the source of any surface wate	r used for drilling:			
Method of dosing and volume of Chlorine	e used in drilling and development: A/A#	grandular		
Logs run (circle all applicable No log run	Electric Gamma Ray Density Sonic Neutr	O ron Other:		
Name of organization running log(s):				
Purpose of borehole (check one): Water W	ell Geotechnical/Geological Investigation G	Fround Source Heat Pump		
Seismic S	Survey Other (<i>describe</i>)			
	to water well construction, skip the remainder of t	his block		
Purpose of Well (check one): Home	ndustrial Public Supply Irrigation Fish Cu	ulture Other:		
If a flowing well, method of flow regulatio		(1) = -1.		
Static Water Level: 15 feet above of below circle one) land surface Date measured: 413311				
Method of Measurement (circle one)	eel tape electric tape air line other:	۰ ۱		
Well depth: 155 Well grouted to a de	pth of Deet Type of grout (circle one): Nea	t Cemen Bentonite Mix		
Casing length: 83 feet Casir	g diameter: inches Type of casi	ng: PVC		
Screen length: 40 feet Scree	en diameter: inches Type of scre	en: <u>PVC</u>		
Screen slot size: 013 inches	Setting depth: From <u>115</u> feet to_	55 feet		
Type of completion (circle all applicable):	Gravel packed Underreamed Telescoped	Open hole Natural Development		
	Other (describe):			
Top of lap pipe or reduction in casing:	5 feet. If telescoped or more than on	e screen, describe on next page		
······································		Form: OLWR-SWR-1A (04/08		


- 4

RECEIVED MAY 3 E 2011


BY: OIME

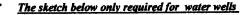

Description of formations encountered must be provided for all wells and boreholes, unless specifically exempted by regulations

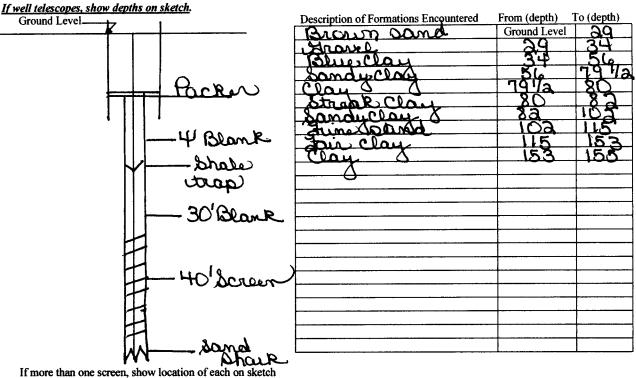



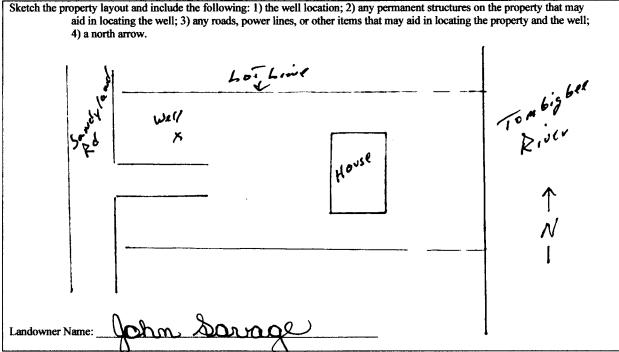

Form: OLWR-SWR-1A (04/08)

I certify that the well/borehole was drilled, constructed, and completed in accordance with all applicable requirements of the Mississippi Department of Environmental Quality and the Mississippi Department of Health regulations, if applicable, and state

UNR00000496 laws. lard DOUDIDE Print Name of Responsible Licensee and License No. Date

Signature of Licensee

MAN 2 5 2017 1944 - CH MAR

STATE WELL REPORT				
County: Clay Permit #: Driller: Clardy Date completed: 413311	Part 2 Pump Installer's Completion Report Mississippi Department of Environmental Quality Office of Land and Water Resources P.O. Box 2309 Jackson, MS 39225 (601)961-5210		For Office Use Only: Aquifer: Well #: Elevation:	
Copy information from block on Part 1	(601)961-5228 (fax)			
This part of the report must be completed b	This part of the report must be completed by a licensed water well contractor or a licensed pump installer. A copy of Part 1 of the			
report must be attached and both parts file				
Well Owner Information Owner Name: John Sarage Mailing Address: 11300 Sandyland		Well Location Latitude: <u>N33°37.(dol</u> Longitude: <u>W088°30</u> .04 Method of Lat/Long (check one): Conventional Survey,		
<u>Core</u>		USGS quad, Hand-held GPSV, Survey-grade GPS		
<u>L. Point, The 39703</u> City State Zip Code		¼ ¼ SecT R Distance Direction Nearest Town		
Telephone No. 238 217 - 21	016	<u>7</u> Miles E of	Westpoint MS.	
Pump Type Circle one		Power Type Circle one		
Air Lift Jet 🤇	Submersible	Diesel Engine Gasoline	e Engine Natural Gas	
Bucket Piston	Turbine	Electric Motor Hand	Tractor PTO	
Centrifugal Rotary	Flowing Well		specify):	
Other (specify):		Horse Power Rating of Motor:	-	
Date Pump Installed: 4/23/11		Setting Depth:feet		
Rated Pump Capacity:15	Gallons Per Minute	Number of Stages:		
Pump Test Data		Method of Measuring Water Level		
Date Well Tested: 41321	1	Ci	rcle one	
Static Water Level (A):Feet Below Land Surface		Air Line Electric Meas Other (specify):		
Pumping Water Level (B):Feet Below Land Surface				
Drawdown [(B) – (A)]:Feet H	Below Land Surface	For flowing well, measured shu	ut in head:feet	
Test Pumping Rate:	Gallons Per Minute	Well yielded	_GPM with a drawdown of	
Duration of Pump Test (minimum 4 hours):	hours	feet after	hours of pumping	
I HEREBY CERTIFY that the above statements are true to the best of my knowledge. Donald B. Clardy- UNRD0000496 Present Scriby Print Name of Pump Installer and License No. (if applicable) Signature of Pump Installer				
			Form: OLWR-SWR-1B (04/08)	

,