

CLAY MISSISSIPPI BOARD OF WATER COMMISSIONERS

J 2000
4-5-61

WATER WELL DRILLERS LOG

H-305

HERNDON WELL & SUPPLY CO.

Date: April 5, 1961, Driller: P. O. BOX 42 County Clay
SHANNON, MISSISSIPPI

(1) Owner of Land:	Description & Color of Materials Sand, Clay, Red Clay, Shell, etc.	Thick- ness Feet	Depth Feet
ETA M. MANNING (Name)	Surface sand		0
West Point (Address)	+ clay		
COULDN'T FIELD LOCATE (2) Location: 1/4, 1/4, Sec. 8 T. 1757 R. 10E	Blue rock		18
1/2 miles East, of West Point. (distance) (direction) (Nearest Town)	+ sand		120
(3) Topography: Flat (Hilly) (Flat) (Level)	+ Bottom		240
(4) Purpose of Well: Home (Domestic Irrigation Municipal, Industrial, Other)			


Information upon completion of well:

- (1) Diameter 4 inches.
- (2) Total Depth 240 feet.
- (3) Water Level 40 feet below top of ground.
- (4) Cased to 22', Size 4"
- (5) Screen: Size —, Length —
- (6) Were any formations sealed against pollution?
 yes, no.

If YES depth of formation 20'

Why Surface + sand

Drillers Remarks:

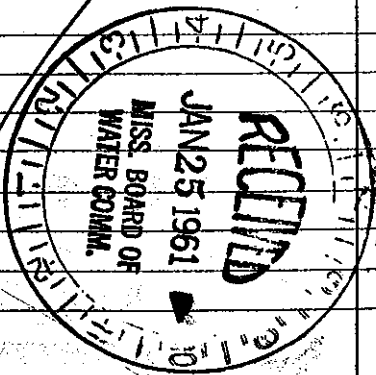

(Use Back Side)

Well No.

Mail this copy to Board of Water Commissioners 429 Miss. St. Jackson. Miss