

CLAY

K23

9-22-62

Date: Sept 22, 1962, Driller: [Signature]

MISSISSIPPI BOARD OF WATER COMMISSIONERS

WATER WELL DRILLERS LOG

HERNDON WELL & SUPPLY CO.

P. O. BOX 42
SHANNON, MISSISSIPPI

CODED

County Clay

(1) Owner of Land	Description & Color of Materials Sand, Clay, Red Clay, Shell, etc.	Thick- ness Feet	Depth Feet
<u>Lucinda Rogers</u> (Name)	<u>clay</u>		<u>0</u>
<u>223 West Point, Miss</u> (Address)	<u>5'</u>		
Location: <u>SW NE SW</u> <u>10</u> <u>19</u> <u>1/4</u> , <u>1/4</u> , Sec. <u>10</u> T. <u>10</u> R. <u>16E</u>	Blue sand		<u>20</u>
<u>5</u> miles <u>S</u> of <u>Warren</u> (distance) (direction) (Nearest Town)	<u>sand</u>		<u>200</u>
(3) Topography: <u>Flat</u> (Hilly) (Flat) (Level)	<u>to</u>		
(4) Purpose of Well: <u>Domestic</u> (Domestic Irrigation Municipal, Industrial, Other)	<u>Bottom</u>		<u>320</u>

Information upon completion of well:


- (1) Diameter 4 inches.
- (2) Total Depth 320 feet.
- (3) Water Level 50 feet below top of ground.
- (4) Cased to 25 ft, Size 4
- (5) Screen: Size —, Length —
- (6) Were any formations sealed against pollution?
 yes, no.

If YES depth of formation 20

Why surface & sand

Drillers Remarks: ELV 5 190
est top 20'

CODED

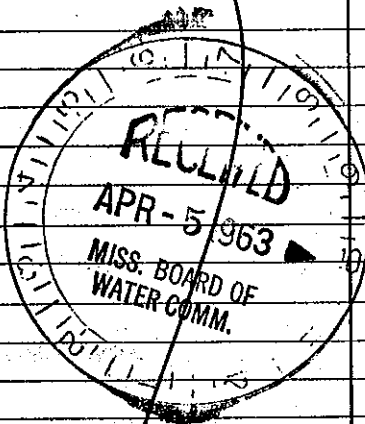

(Use Back Side)

Well No.

Mail this copy to Board of Water Commissioners 429 Miss. St. Jackson, M