

F.H.A. CLAY  
K 37  
12-6-73

MISSISSIPPI  
 BOARD OF WATER COMMISSIONERS  
 416 North State Street  
 Jackson, Mississippi 39201

WATER WELL DRILLERS LOG

CODED

12/6 1973 HERMAN ECHOLS Clay  
 date well completed firm name county well located


LANDOWNER	description of formations encountered	from	to
<u>Cleveland Harwin</u>	<u>Sandy clay</u>	<u>0</u>	<u>12</u>
<u>West Point, Miss</u>	<u>High Rock</u>	<u>12</u>	<u>180</u>
(mailing address)	<u>Sand</u>	<u>180</u>	<u>300</u>

WELL LOCATION:  
 sec. 11 T. 18 N. R. 10 E.  
5 miles SE of West Point  
 (distance) (direction) (nearest town)

WELL PURPOSE: HOME  
 (home, irrigation, municipal, industrial)

- WELL COMPLETION DATA:
- (1) diameter (inches) 5"
  - (2) total depth (feet) 300
  - (3) static water level (feet) 80 below above top of ground.
  - (4) casing 2 1/2" steel  
 (material) (depth)  
 (size) if telescope see back.
  - (5) screen 0  
 (length) (depth to top)  
 (size) (material)
  - (6) pump 1/2 8  
 (HP) (yield gpm)  
6 hp  
 (type power)
  - (7) electric log (yes or no)  
 (organization running log)
  - (8) how well bottom plugged

CODED

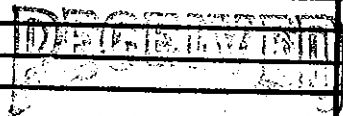

JAN 7 1974

DRILLERS REMARKS: