

State Well Report

Part 1

Mississippi Department of Environmental Quality
Office of Land and Water Resources
P.O. Box 10631
Jackson, MS 39289-0631
(601)961-5210
(601)354-6938 (fax)

County: Clay
Permit #: _____
Driller: David Brown
Date drilling completed: 11/9/04

For Office Use Only:
Aquifer: _____
Well #: K-49 25
L. S. Elevation: _____
E-log #: _____

State Law requires that this report be prepared by the driller in detail and filed with the Department within 30 days of completion of drilling of the well.

Well Owner Information	Well Location
Owner Name <u>Catalpa Plantation Assn.</u>	Latitude: _____ Longitude: _____
Mailing Address: <u>210 5th St. S.</u>	Method of Lat/Long (circle one): <u>Conventional Survey</u>
<u>Columbus, MS 39701</u>	USGS quad, Hand-held GPS, Survey-grade GPS
City State Zip Code	SW $\frac{1}{4}$ SE $\frac{1}{4}$ Sec <u>12</u> Twn <u>19N</u> Rng <u>16E</u>
Telephone No. <u>(662)251-3015</u>	Distance Direction Nearest Town <u>5</u> Miles <u>SE</u> of <u>WestPoint</u>

Well Data

Purpose of Well (circle one) Home Industrial Public Supply Irrigation Fish Culture Other: _____

Date well drilling started: 11/8/04 Date well drilling completed: 11/9/04

If flowing, method of flow regulation: Valve _____ Other (describe) _____

Static Water Level: 46 feet above or below (circle one) land surface Date measured: 11/9/04

Method of Measurement (circle one) steel tape electric tape air line other: _____

Hole depth: 321 Well depth: 321 Well grouted to a depth of 10 feet

Type of grout (circle one): Cement Bentonite Mix

Casing length: 125 feet Casing diameter: 4 inches Type of casing: PVC

Screen length: n/a feet Screen diameter: _____ inches Type of screen: _____

Screen slot size: _____ inches Setting depth: From _____ feet to _____ feet

Type of completion (circle all applicable): Gravel packed Underreamed Telescoped Open hole Natural Development

Other (describe): _____

Top of lap pipe or reduction in casing: _____ feet. If telescoped or more than one screen, describe on back of page

Logs run (circle all applicable): No log run Electric Gamma Ray Density Sonic Neutron Other: _____

Name of organization running log(s): _____

I certify that the well was drilled, constructed, and completed in accordance with all applicable requirements of the Mississippi Department of Environmental Quality and/or the Mississippi Department of Health regulations and state laws.

Mid-South Drilling Company, Inc.
David C. Brown #0-654

David C. Brown
Signature of Water Well Contractor


Print Name of Water Well Contractor and License No.

RECEIVED
NOV 16 2004
BY: OLWF

(25)

If well telescopes please sketch below and show depths.


Ground Level

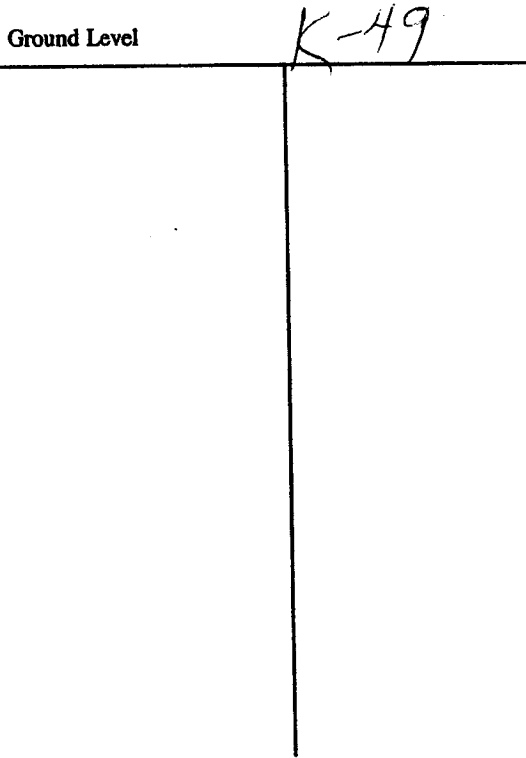

Description of Formations Encountered	From	To
Clay	0	10
Sand	10	16
Coarse sand	16	25
Clay	25	163
Sand	163	186
Rock	186	187
Sand	187	215
Clay w/sand streaks	215	270
Sand	270	285
Sand w/clay streaks	285	310
Clay w/sand streaks	310	321

If more than one screen, show location of each on sketch

Sketch the property layout and include the following: 1) the well location; 2) any permanent structures on the property that may aid in locating the well; 3) any roads, power lines, or other items that may aid in locating the property and the well; 4) indicate direction.

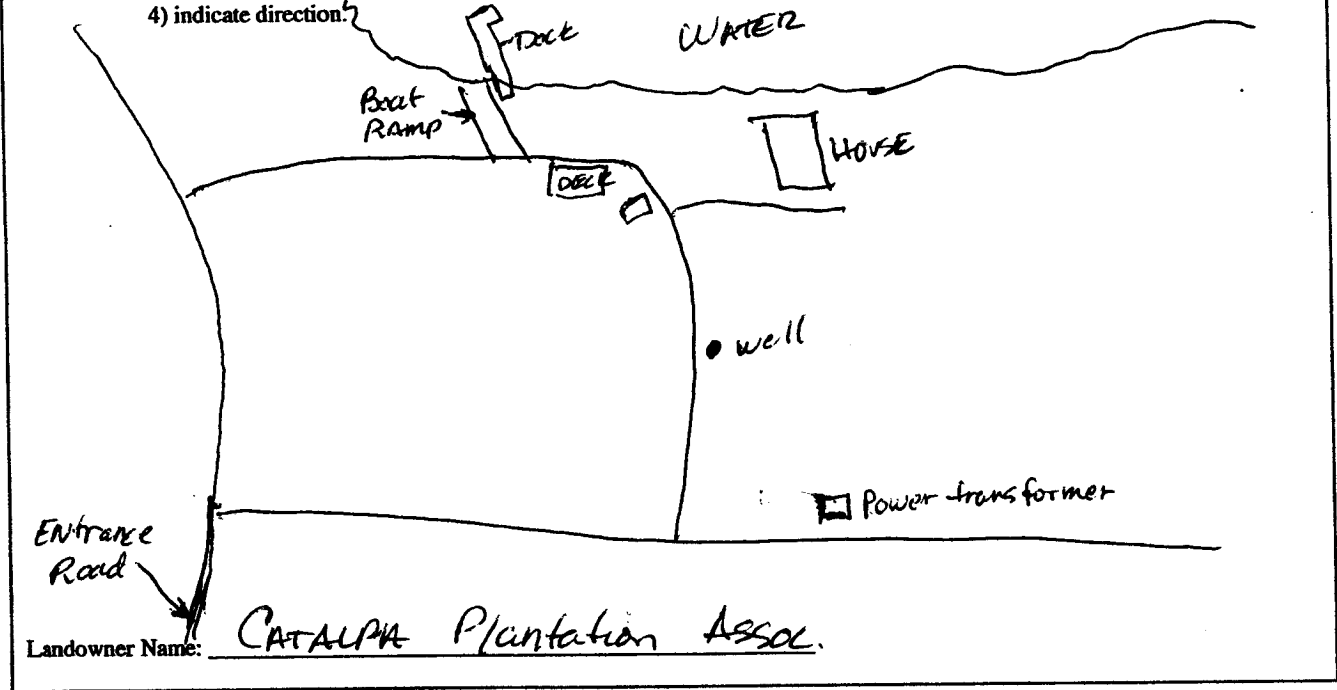

David C. Brown
 Signature of Water Well Contractor

RECEIVED
 NOV 16 2004
 BY: OLWR

STATE WELL REPORT

Part 2

Pump Installer's Completion Report
 Mississippi Department of Environmental Quality
 Office of Land and Water Resources
 P.O. Box 10631
 Jackson, MS 39289-0631
 (601)961-5210
 (601)354-6938 (fax)

County: Clay
 Permit #: _____
 Driller: David Brown
 Date completed: 11/9/04

For Office Use Only:

Aquifer: _____
 Well #: K-49
 Elevation: _____

This report should be prepared by the pump installer in detail and filed with the Department within 30 days of the installation of pump.

Well Owner Information	Well Location
Owner Name: <u>Catalpa Plantation Assn.</u>	Latitude: _____ Longitude: _____
Mailing Address: <u>210 5th St. S.</u>	Method of Lat/Long (circle one): <u>Conventional Survey,</u>
<u>Columbus</u> MS <u>39701</u>	USGS quad, Hand-held GPS, Survey-grade GPS
City State Zip Code	<u>SW 1/4 SE 1/4 Sec 12 Twn 188 Rng 16E</u>
Telephone No. (____) _____	Distance Direction Nearest Town
	<u>5</u> Miles <u>SE</u> of <u>WestPoint</u>

Pump Type Circle one	Power Type Circle one
Air Lift Jet Submersible	Diesel Engine Gasoline Engine Natural Gas
Bucket Piston Turbine	Electric Motor Hand Tractor PTO
Centrifugal Rotary Flowing Well	Windmill Other (specify): _____
Other (specify): _____	Horse Power Rating of Motor: <u>3/4</u>
Date Pump Installed: <u>11/9/04</u>	Setting Depth: <u>120</u> feet
Rated Pump Capacity: <u>12</u> Gallons Per Minute	Number of Stages: <u>11</u>

Pump Test Data	Method of Measuring Water Level Circle one
Date Well Tested: <u>11/9/04</u>	Air Line Electric Measuring Line Steel Tape
Static Water Level (A): <u>46</u> Feet Below Land Surface	Other (specify): _____
Pumping Water Level (B): <u>65</u> Feet Below Land Surface	For flowing well, measured shut in head: _____ feet
Drawdown [(B) - (A)]: <u>19</u> Feet Below Land Surface	Well yielded <u>15</u> GPM with a drawdown of
Test Pumping Rate: <u>15</u> Gallons Per Minute	<u>19</u> feet after <u>4</u> hours of pumping
Duration of Pump Test (minimum 4 hours): <u>4</u> hours	

I HEREBY CERTIFY that the above statements are true to the best of my knowledge.

David Brown 0-654 David C. Brown
 Print Name of Pump Installer and License No. (if applicable) Signature of Pump Installer

RECEIVED
 NOV 16 2004
 BY: OLWR