

A-30

A
4-3-61

WATER WELL DRILLERS LOG

Date: April 3, 1961, Driller: Layne-Central Company County Coahoma

(Name)

(1) Owner of Land: <u>A. V. Shannon</u> (Name)	Description & Color of Materials Sand, Clay, Red Clay, Shell, etc.	Thick- ness Feet	Depth Feet
<u>Lula, Mississippi</u> (Address)	Clay	36	36
	Sand	12	48
(2) Location: <u>1/4, 1/4, Sec. 17 T22R4,</u> <u>West of 61 Highway, at Lula</u> <u>Junction.</u> miles _____ of _____ (distance) (direction) (Nearest Town)	Coarse sand	42	90
(3) Topography: <u>flat</u> (Hilly) (Flat) (Level)			
(4) Purpose of Well: <u>irrigation</u> (Domestic Irrigation Municipal, Industrial, Other)			


Information upon completion of well:

- (1) Diameter 8 inches.
- (2) Total Depth 92 feet.
- (3) Water Level 6' - 8" feet below top of ground.
- (4) Cased to 52', Size 8"
- (5) Screen: Size 8", Length 40'
- (6) Were any formations sealed against pollution?
no yes, X no.

If YES depth of formation _____

Why _____

Drillers Remarks: _____

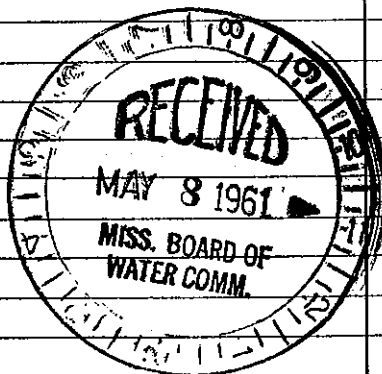

Well No.

(Use Back Side)