

ELOG # 10

MISSISSIPPI BOARD OF WATER COMMISSIONERS  
416 North State Street  
Jackson, Mississippi 39201

**CODED**

WATER WELL DRILLERS LOG

Coahoma  
A8  
10-2-68  
C# 05714

10-2-1968 date well completed  
Layne-Central Company firm name  
Coahoma county well located

LANDOWNER: Town of Lula  
Lula, Mississippi

(mailing address)

WELL LOCATION:  
sec. 23 T. 30N R. 2E  
S W  
(distance) miles of (direction) (nearest town)


WELL PURPOSE: municipal  
(home, irrigation, municipal, industrial)

WELL COMPLETION DATA:

- (1) diameter (inches) 10"
- (2) total depth (feet) 1069'
- (3) static water level (feet) 6' 5" below top of ground.
- (4) casing steel 356' (material) (depth) 10" (size) If telescope see back.
- (5) screen 63' 6" 998' 8" (length) (depth to top) 10" & 6" wire wrapped s.s. (size) (material)
- (6) pump 15 200 (HP) (yield gpm) Electric (type power)
- (7) electric log (yes or no) (organization running log)
- (8) how well bottom plugged

description of formations encountered	from	to
Clay	16	16
fine gray sand	68	52
sand	98	30
coarse sand-pea gravel	112	14
coarse sand-gravel	167	55
sandy clay	173	6
sand	187	14
sand-clay stks	242	55
sandy clay-stks sand	280	38
sand	341	141
clay	371	30
sand-stks shale	411	40
shale	472	61
sandy shale	490	18
shale	524	34
sandy shale	564	40
sandy shale-stks sand	578	14
sand	650	72
shale	653	3
rock	655	2
clay	668	13
rock	670	2
clay	700	30
rock	701	1
shale	823	122
hard clay	956	133
sandy shale	986	30
sand-stks shale	1009	23
shale	1013	4
sand	1068	55
shale	1069	1

**CODED**

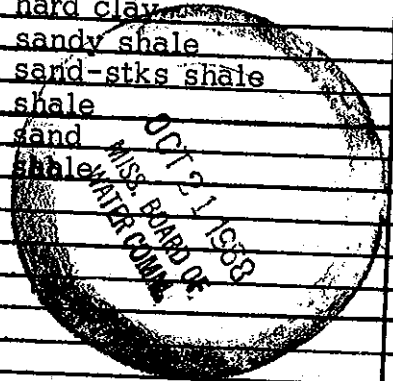

DRILLERS REMARKS: