

MISSISSIPPI BOARD OF WATER COMMISSIONERS

COAHOMA

A 13


8-19-63

WATER WELL DRILLERS LOG

Date: 8/19, 1963, Driller: Bailey Drlg Co Washington County

	Description & Color of Materials Sand, Clay, Red Clay, Shell, etc.	Thick- ness Feet	Depth Feet
(1) Owner of Land: <u>J W Corley</u> (Name) <u>Lula, Miss.</u> (Address)	Clay		19
	Sand		78
	Gravel		121
(2) Location: $\frac{1}{4}$, $\frac{1}{4}$, Sec. <u>34^N</u> T <u>30</u> R <u>5^W</u> <u>at Lula</u> Miles _____ of _____ (distance) (direction) (Nearest Town)	Mud		420
	Sand		471
	Mud		554
(3) Topography: <u>Flat</u> (Hilly) (Flat) (Level)	Sand + Mud		596
	Mud		700
(4) Purpose of Well: <u>Domestic</u> (Domestic Irrigation Municipal, Industrial, Other)	Sand		730
	Mud		748
	Sand + Mud		820
	Mud		890
	Sand + Mud		1052
	Sand		1068
	Mud		1170
	Sand		1250
Information upon completion of well:			
(1) Diameter <u>4 X 3 X 2 1/2</u> inches.			
(2) Total Depth <u>1250</u> feet.			
(3) Water Level <u>Ground level</u> feet below top of ground.			
(4) Cased to <u>all way</u> Size <u>4 X 3 X 2 1/2</u>			
(5) Screen: Size <u>2 1/2</u> , Length <u>30ft</u>			
(6) Were any formations sealed against pollution? _____ yes, <u>X</u> no.			
If YES depth of formation _____			
Why _____			
Drillers Remarks: _____			

[Handwritten signature]

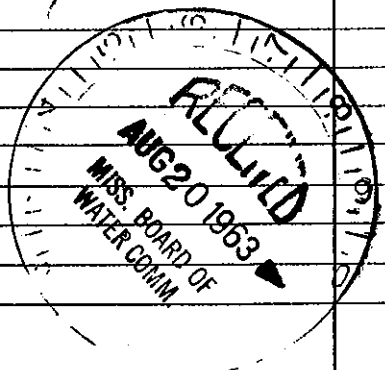

Well No.

(Use Back Side)

Mail this copy to Board of Water Commissioners 429 Miss. St. Jackson, Miss