

County: Coahoma
 Permit #: _____
 Driller: Pete's Well Drilling
 Date drilling completed: 12-16-07

Well Driller Report and Well Log

Mississippi Department of Environmental Quality
 Office of Land and Water Resources
 P.O. Box 10631
 Jackson, MS 39289-0631
 (601)961-5210
 (601)354-6938 (fax)

For Office Use Only:
 Aquifer: _____
 Well #: A-32
 L. S. Elevation: _____
 B-log #: _____

State Law requires that this report be prepared by the driller in detail and filed with the Department within 30 days of completion of drilling of the well.

Well Owner Information	Well Location
Owner Name: <u>Woody Woods</u>	Latitude: <u>34° 26' 42.5"</u> Longitude: <u>90° 28' 26.3" W</u>
Mailing Address: <u>Rich to Moon Lake Rd</u>	Method of Lat/Long (circle one): <u>Hand-held GPS</u> , Conventional Survey, USGS quad, Survey-grade GPS
<u>Lula, MS 38644</u>	NE 1/4 SE 1/4 Sec <u>26</u> Twn <u>30N</u> Rng <u>3W</u>
City State Zip Code	Distance Direction Nearest Town
Telephone No. <u>(662) 337-4226</u>	<u>1</u> Miles <u>SE</u> of <u>Lula MS</u>

Well Data

Purpose of Well (circle one) Home Industrial Public Supply Irrigation Fish Culture Other: _____

Date well drilling started: 12-16-07 Date well drilling completed: 12-16-07

If flowing, method of flow regulation: Valve _____ Other (describe) _____

Static Water Level: 20 feet above or below (circle one) land surface Date measured: 12-16-07

Method of Measurement (circle one) steel tape electric tape air line other: _____

Hole depth: 110 Well depth: 110 Well grouted to a depth of 10 feet

Type of grout (circle one): Cement Bentonite Mix

Casing length: 70 feet Casing diameter: 12 inches Type of casing: PVC

Screen length: 40 feet Screen diameter: 12 inches Type of screen: PVC

Screen slot size: 032 inches Setting depth: From 70 feet to 110 feet

Type of completion (circle all applicable): Gravel packed Underreamed Telescoped Open hole Natural Development

Other (describe): _____

Top of lap pipe or reduction in casing: _____ feet. If telescoped or more than one screen, describe on back of page

Logs run (circle all applicable): No log run Electric Gamma Ray Density Sonic Neutron Other: _____

Name of organization running log(s): _____

I certify that the well was drilled, constructed, and completed in accordance with all applicable requirements of the Mississippi Department of Environmental Quality and/or the Mississippi Department of Health regulations and state laws.

Pete's Well Drilling 0431 Signature of Water Well Contractor [Signature]

If well telescopes please sketch below and show depths.

JAN 02 2008
 BY: OLWR

A.32

Ground Level


Description of Formations Encountered

From To

Description of Formations Encountered	From	To
CLAY	0	20
LINK SAND	20	65
COURSE SAND + GRAVEL	65	110

If more than one screen, show location of each on sketch

Sketch the property layout and include the following: 1) the well location; 2) any permanent structures on the property that may aid in locating the well; 3) any roads, power lines, or other items that may aid in locating the property and the well; 4) indicate direction.

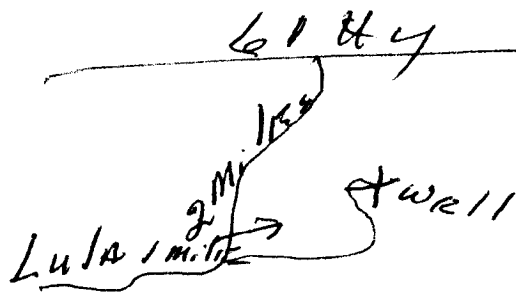

Landowner Name: Woody Woods

[Handwritten Signature]
Signature of Water Well Contractor

RECEIVED

JAN 02 2008

BY: OLWR

STATE WELL REPORT

Part 2

Pump Installer's Completion Report
 Mississippi Department of Environmental Quality
 Office of Land and Water Resources
 P.O. Box 10631
 Jackson, MS 39289-0631
 (601)961-5210
 (601)354-6938 (fax)

For Office Use Only:

Aquifer: _____
 Well #: A-32
 Elevation: _____

County: COAHOMA
 Permit #: _____
 Driller: PETE'S WELL DRILLING
 Date completed: 12-16-07
Copy information from block on Part 1


This part of the report must be completed by a licensed water well contractor or a licensed pump installer. A copy of Part 1 of the report must be attached and both parts filed with the Department at the above address within 30 days of well completion.

Well Owner Information	Well Location
Owner Name: <u>Woody Woods</u>	Latitude: <u>34° 26' 42.5"</u> Longitude: <u>90° 28' 26.3"</u>
Mailing Address: <u>Rich to Moon Lake Rd</u>	Method of Lat/Long (check one): Conventional Survey _____
<u>Lula</u> MS <u>38644</u>	USGS quad _____ <input checked="" type="checkbox"/> Hand-held GPS _____ Survey-grade GPS _____
City State Zip Code	¼ Sec _____ T _____ R _____
Telephone No. <u>(662) 337-4226</u>	Distance _____ Direction _____ Nearest Town _____
	<u>1</u> Miles <u>SE</u> of <u>Lula</u>

Pump Type Circle one	Power Type Circle one
Air Lift Jet Submersible	<input checked="" type="checkbox"/> Diesel Engine Gasoline Engine Natural Gas
Bucket Piston <input checked="" type="checkbox"/> Turbine	Electric Motor Hand Tractor PTO
Centrifugal Rotary Flowing Well	Windmill Other (specify): _____
Other (specify): _____	Horse Power Rating of Motor: <u>80</u>
Date Pump Installed: <u>12-20-07</u>	Setting Depth: 70 <u>60</u> feet
Rated Pump Capacity: <u>1200</u> Gallons Per Minute	Number of Stages: 2 <u>3</u>

Pump Test Data	Method of Measuring Water Level Circle one
Date Well Tested: _____	Air Line Electric Measuring Line <input checked="" type="checkbox"/> Steel Tape
Static Water Level (A): <u>20</u> Feet Below Land Surface	Other (specify): _____
Pumping Water Level (B): _____ Feet Below Land Surface	For flowing well, measured shut in head: _____ feet
Drawdown [(B) - (A)]: _____ Feet Below Land Surface	Well yielded _____ GPM with a drawdown of _____ feet after _____ hours of pumping
Test Pumping Rate: _____ Gallons Per Minute	
Duration of Pump Test (minimum 4 hours): _____ hours	

I HEREBY CERTIFY that the above statements are true to the best of my knowledge.

David P. Holt 0-752P 
 Print Name of Pump Installer and License No. (if applicable) Signature of Pump Installer

Form: OLWR-SWR-1B

RECEIVED
 JAN 07 2008
 BY: OLWR

JOB # 7544