

Coahoma  
B10  
10-66

MISSISSIPPI BOARD OF WATER COMMISSIONERS

**CODED**

WATER WELL DRILLERS LOG

Date: 10-28, 1966, Driller Butane Gas Co. County Coahoma  
(Name)

(1) Owner of Land: John B. McKee  
(Name)  
FRIARS POINT  
(Address)

(2) Location: NW 1/4, SE 1/4, Sec 23 T29R4W  
4 miles E, of Friars Point  
(distance) (direction) (Nearest Town)

(3) Topography:  (Level)  
(Hilly) (Flat) (Level)

(4) Purpose of Well: Domestic  
(Domestic Irrigation, Municipal, Industrial, Other)

Description & Color of Materials Sand, Clay, Red Clay, Shell, etc.	Thick- ness Feet	Depth Feet
Clay	18	18
Sand	42	60
Sand + Gravel	70	130
Shale	6	136
Hard Rock	1	137
Shale	53	190
Rock	1	191
Shale	92	283
Sand + Shale	208	491
Brown Shale	8	499
Gray Shale	3	502
Clay	133	635
Sand	25	660
Clay	450	1110
Brown Sand	40	1150


Information upon completion of well:

- (1) Diameter 4 3/4 inches.  
(2) Total Depth 1150 feet.  
(3) Water Level 7' 6" feet below top of ground.  
(4) Cased to 1143, Size 4" x 2 1/2.  
(5) Screen: Size 2", Length 30'.  
(6) Were any formations sealed against pollution?  
\_\_\_\_\_ yes,  no.

If YES depth of formation \_\_\_\_\_

Why \_\_\_\_\_

Drillers Remarks: \_\_\_\_\_

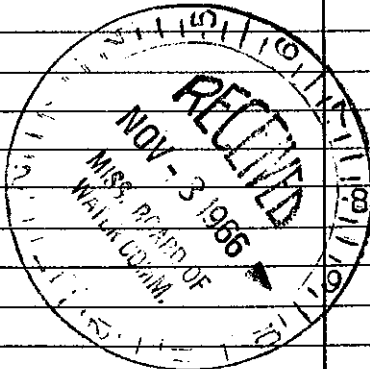

(Use Back Side)

Well No.