| State Well  | Report  |
|---|---|
| County: Coahoma Part 1  |   |
| GW16131 Mississippi Department of E   |   |
| Irrigation Equipment Office of Land and W   |   |
| Insteam MC 20   | /051  |
| Date drilling completed: $\frac{1-6-05}{(601)961-5}$  | 210   |
| Migiation Equipment, and (601)354-693   | 8 (fax) E-log #:  |
| State Law requires that this report be prepared by the drille                                   | r in detail and filed with the Department within  |
| 30 days of completion of drilling of the well.<br>Well Owner Information                        |   |
| Morri Moulor Folle  | Well Location           34         22.37         2N         90         36.16         1W |
| Uwiter Name Latin   | 34 22.37 2N 90 36.16 1W<br>ude:' Longitude:'  |
| Mailing Address: 122 River Bend Med   | nod of Lat/Long (circle one): Conventional Survey,                                      |
|   | USGS quad, Hand-beld GPS, Survey-grade GPS  |
| Clarksdale, MS 38614 NW   | <u>4 NW</u> 4 Sec_22 Twn 29N Rng 4W   |
| City State Zip Code   |   |
| Telephone No. ()  | Ance Direction Nearest Town<br>2 Miles East of Friars Point                             |
| Well Data<br>Purpose of Well (circle one) Home Industrial Public Supply Irrig                   | Augmentation  |
| Date well drilling started: 1-6-05 Date well dr   | 1-6-05  |
| If flowing, method of flow regulation: Valve Other (describ                                     |   |
| Static Water Level: 13ft. feet above or below (circle one) land so                              | rface Date measured: <u>1-13-05</u>   |
| Method of Measurement (circle one) steel tape electric tape                                     | hir line other:   |
| Hole depth: 146 Well depth: 146 We  | all grouted to a depth offeet   |
| Type of grout (circle one): Cement Bentonite Mix  |   |
| Casing length: 86 feet Casing diameter: 16 incl   | es Type of casing: PVC Sch. 40  |
| Screen length: $60$ feet Screen diameter: $16$ incl   |   |
| Screen slot size:inches Setting depth: From   | 01 140  |
| Type of completion (circle all applicable): Gravel packed Underreament                          | I Telescoped Open hole Natural Development  |
|   |   |
| fop of lap pipe or reduction in casing:feet. If telescop  | ed or more than one screen, describe on back of nage                                    |
| ogs run (circle all applicable): No log run Electric Gamma Ray Den                              |   |
| Name of organization running log(s):  |   |
| certify that the well was drilled, constructed, and completed in accord                         | ance with all applicable requirements of the Mississippi, really re-                    |
| Department of Environmental Quality and/or the Mississippi Department Irrigation Equipment Inc. | nt of Health regulations and state laws.  |
| Patrick M. Chism 0695   | Patrik M Chia FEB 0 P 2005  |
| Print Name of Water Well Contractor and License No.   | Signature of Water Well Contractor BY: OLW  |

.


•

If well telescopes please sketch below and show depths.

Ground Level

| Description of Formations Encountered | From     | То           |
|---------------------------------------|----------|--------------|
| Clay .                                | 0        | 31           |
| Fine Sand                             | 32       | 6(           |
| Fine Sand/gravel                      | 61       | 73           |
| Fine Sand/gravel<br>Med. Sand/gravel  | 74       | 14           |
| Fine Sand                             | 141      | 14           |
|                                       |          | <u> </u>     |
|                                       | <u>_</u> |              |
|                                       |          |              |
|                                       |          | -            |
| ·                                     |          |              |
|                                       | ·        |              |
|                                       |          |              |
|                                       |          |              |
|                                       |          | <u> </u>     |
|                                       |          |              |
|                                       |          |              |
|                                       |          |              |
|                                       |          | 1            |
|                                       |          | 1            |
| ·····                                 |          |              |
|                                       |          | 1            |
| · · · · · · · · · · · · · · · · · · · |          | <del> </del> |
|                                       |          |              |
|                                       |          |              |
|                                       |          |              |
|                                       |          |              |

If more than one screen, show location of each on sketch

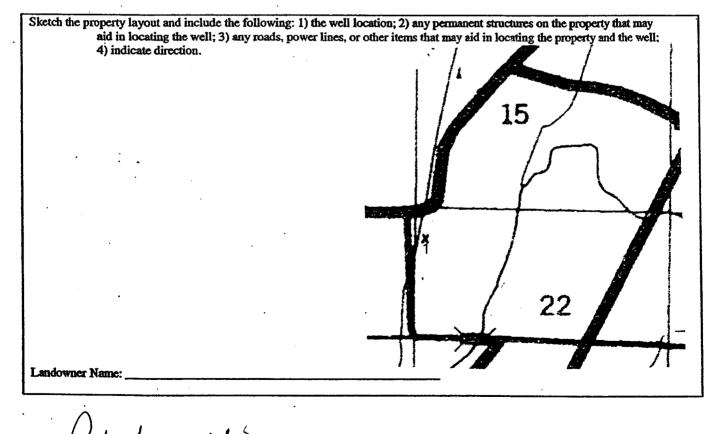

Signature of Water Well Contractor

| 's Completion Report         and of Environmental Quality         and Water Resources         Box 10631         MS 39289-0631         1961-5210         54-6938 (fax) |
|---|
| ail and filed with the Department within 30 days of the Well Location   |
| Latitude:Longitude:   |
| Method of Lat/Long (circle one): Conventional Survey,   |
| USGS quad, Hand-heid GPS, Survey-grade GPS  |
| $\frac{NW}{M} \frac{NW}{4} \frac{Sec}{22} \frac{22}{Twn} \frac{29N}{Rng} \frac{4W}{4}$  |
| Distance Direction Nearest Town   |
| <u>2</u> <u>Miles</u> East of Frairs Point  |
| Power Type  |
| Circle one  |
| Diesel Engine Gasoline Engine Natural Gas   |
| Electric Motor Hand Tractor PTO   |
| Windmill Other (specify):   |
| Horse Power Rating of Motor:60  |
| Setting Depth:70feet  |
| Number of Stages:1  |
| Method of Measuring Water Level   |
| Circle one Air Line Electric Measuring Line Steel Tape  |
| Other (specify):  |
| Other (specify):  |
| For flowing well, measured shut in head:feet  |
| Well yielded GPM with a drawdown of   |
| feet afterhours of pumping  |
| 4   |

^

•

l