

#10-461

State Well Report

Part 1 - Driller's Log

Mississippi Department of Environmental Quality
Office of Land and Water Resources
P.O. Box 2309
Jackson, MS 39225
(601)961- 5210
(601)961- 5228 (fax)

County: Coahoma
 Permit #: GW-44428
 Driller: Pete Sappington
 Date drilling completed: 7-28-10

For Office Use Only:
 Aquifer: B69
 Well #: _____
 L. S. Elevation: _____
 E-log #: _____

State Law requires that this report be prepared by the license holder responsible for the work and filed with the Department at the above address within 30 days of completion of drilling of the well or borehole.

Information on Well Owner (Landowner if borehole is not for a water well)	Well or Borehole Location
Owner Name: <u>McKee Bros. Trust</u>	Latitude: <u>34° 21' 42.2"</u> Longitude: <u>90° 39' 24.5"</u>
Mailing Address: <u>5872 Ridgeband Rd.</u>	Method of Lat/Long (circle one): Conventional Survey, <u>Hand-held GPS</u>
<u>Memphis</u> <u>Tenn</u> <u>38120</u>	USGS quad, <u>IR 1/4</u> <u>IR 1/4</u> Sec <u>10</u> Twn <u>45</u> Rng <u>5E</u>
City State Zip Code	Distance <u>1 1/2</u> Miles Direction <u>W</u> of Nearest Town <u>Frierspoint</u>
Telephone No. <u>(901) 680-7700</u>	

Well / Borehole Data

Date drilling started: 7-27 Date drilling completed: 7-28 Hole depth: 100' Hole diameter: 28"

Location of the source of any surface water used for drilling: Lake on river side of Miss Levee
 Method of dosing and volume of Chlorine used in drilling and development: Sodium Hypo Chlorite E paper

Logs run (circle all applicable): No log run Electric Gamma Ray Density Sonic Neutron Other: _____
 Name of organization running log(s): _____

Purpose of borehole (check one): Water Well Geotechnical/Geological Investigation _____ Ground Source Heat Pump _____
 Seismic Survey _____ Other (describe) _____
If drilling is not related to water well construction, skip the remainder of this block

Purpose of Well (check one): Home _____ Industrial _____ Public Supply _____ Irrigation Fish Culture _____ Other: _____

If a flowing well, method of flow regulation: Valve _____ Other (describe) _____

Static Water Level: 18' feet above or below (circle one) land surface Date measured: 7-29-10

Method of Measurement (circle one) steel tape electric tape air line other: _____

Well depth: 100 Well grouted to a depth of 10 feet Type of grout (circle one): Neat Cement Bentonite Mix

Casing length: 60 feet Casing diameter: 16 inches Type of casing: PVC-40

Screen length: 40 feet Screen diameter: 16 inches Type of screen: PVC-40

Screen slot size: .032 inches Setting depth: From 60 feet to 100 feet

Type of completion (circle all applicable): Gravel packed Underreamed Telescoped Open hole Natural Development
 Other (describe): _____


Top of lap pipe or reduction in casing: _____ feet. *If telescoped or more than one screen, describe on next page*

Form: OLWR-SWR-1A (04/08)

RECEIVED

AUG 19 2010

BV-OJWF

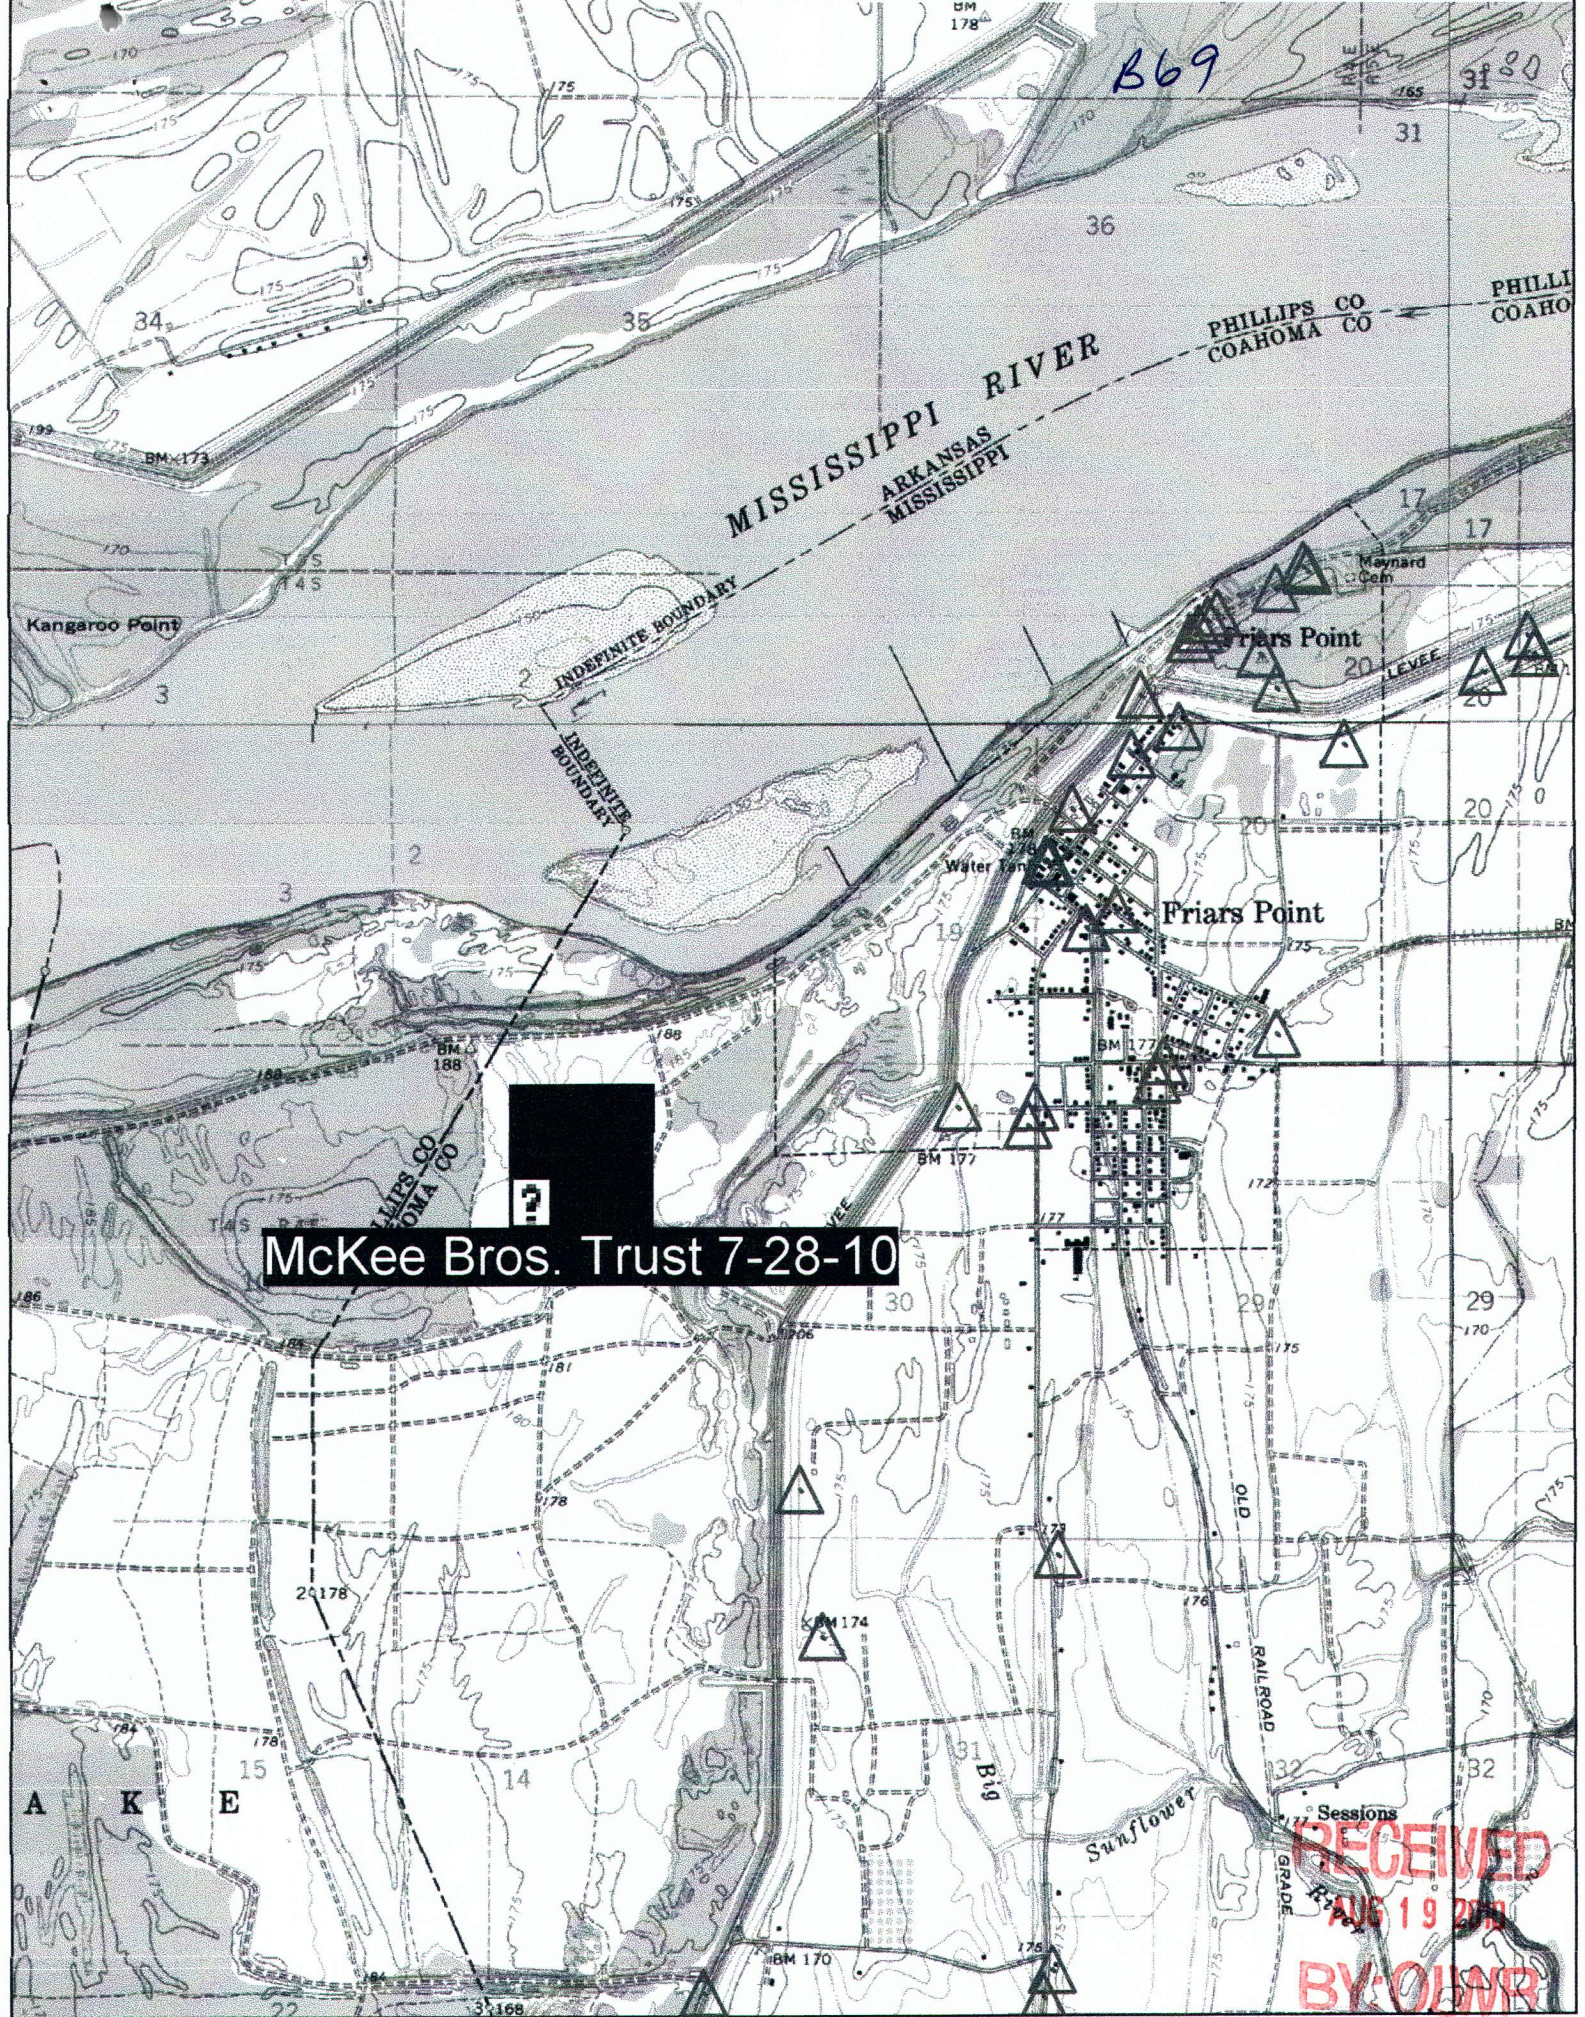

B69

MISSISSIPPI RIVER
ARKANSAS
MISSISSIPPI

PHILLIPS CO
COAHOMA CO

Kangaroo Point

INDEFINITE BOUNDARY

Friars Point

Friars Point

McKee Bros. Trust 7-28-10

RECEIVED
AUG 19 2010
BY OLNR

STATE WELL REPORT

Part 2

Pump Installer's Completion Report
 Mississippi Department of Environmental Quality
 Office of Land and Water Resources
 P.O. Box 2309
 Jackson, MS 39225
 (601)961-5210
 (601)961-5228 (fax)

County: COAHOMA
 Permit #: GW-44428
 Driller: PETE SAPPINGTON
 Date completed: 7-28-10
Copy information from block on Part 1

For Office Use Only:

Aquifer: B7X 69
 Well #: _____
 Elevation: _____

This part of the report must be completed by a licensed water well contractor or a licensed pump installer. A copy of Part 1 of the report must be attached and both parts filed with the Department at the above address within 30 days of well completion.

Well Owner Information	Well Location
Owner Name: <u>McKee Bros Trust</u>	Latitude: <u>34° 21' 42.2"</u> Longitude: <u>90° 39' 24.5"</u>
Mailing Address: <u>5872 Ridgebend Rd</u>	Method of Lat/Long (check one): Conventional Survey _____ USGS quad _____, Hand-held GPS _____, Survey-grade GPS _____ _____ ¼ _____ ¼ Sec <u>10</u> T <u>45</u> R <u>4E</u>
<u>Memphis, TN 38120</u> City State Zip Code	Distance Direction Nearest Town <u>1.2</u> Miles <u>WSW</u> of <u>Friars Point</u>
Telephone No. <u>(901) 680-7700</u>	

Pump Type Circle one	Power Type Circle one
Air Lift Jet Submersible	<u>Diesel Engine</u> Gasoline Engine Natural Gas
Bucket Piston <u>Turbine</u>	Electric Motor Hand Tractor PTO
Centrifugal Rotary Flowing Well	Windmill Other (specify): _____
Other (specify): _____	Horse Power Rating of Motor: <u>125</u>
Date Pump Installed: <u>7-29-10</u>	Setting Depth: <u>70</u> feet
Rated Pump Capacity: <u>1500</u> Gallons Per Minute	Number of Stages: <u>1</u>

Pump Test Data	Method of Measuring Water Level Circle one
Date Well Tested: _____	Air Line Electric Measuring Line <u>Steel Tape</u>
Static Water Level (A): <u>16</u> Feet Below Land Surface	Other (specify): _____
Pumping Water Level (B): _____ Feet Below Land Surface	For flowing well, measured shut in head: _____ feet
Drawdown [(B) - (A)]: _____ Feet Below Land Surface	Well yielded _____ GPM with a drawdown of _____ feet after _____ hours of pumping
Test Pumping Rate: _____ Gallons Per Minute	
Duration of Pump Test (minimum 4 hours): _____ hours	

I HEREBY CERTIFY that the above statements are true to the best of my knowledge.

DAVID P. HOLT 0-752P _____
 Print Name of Pump Installer and License No. (if applicable) Signature of Pump Installer

Form: OLWR-SWR-1B (04/08)

RECEIVED

AUG 26 2010

BY: OLWR

103
10-461